

#4437

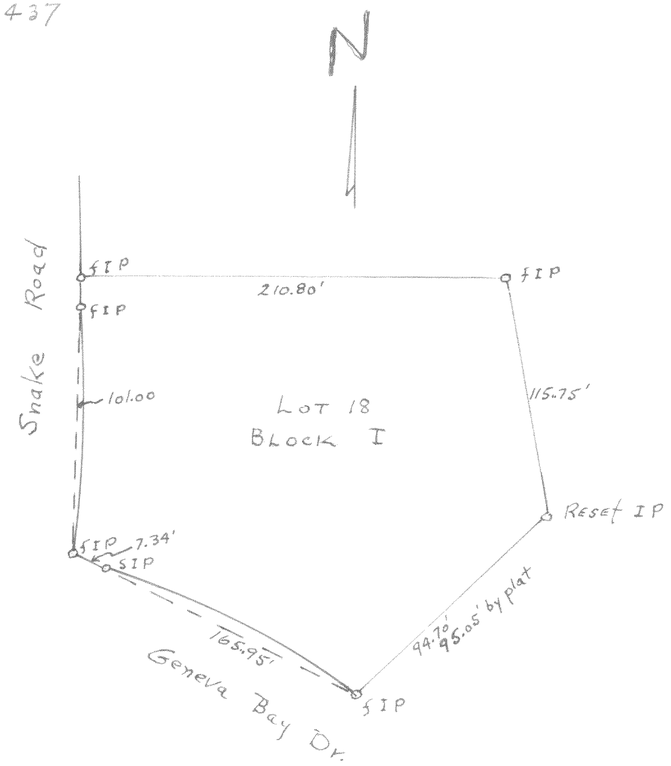

Survey of Lot 18 of Geneva Bay Estates in Section 35, T2N R17E (BLOCK I)
Feb. 1963

Floyd F Iverson
County Surveyor

#4438

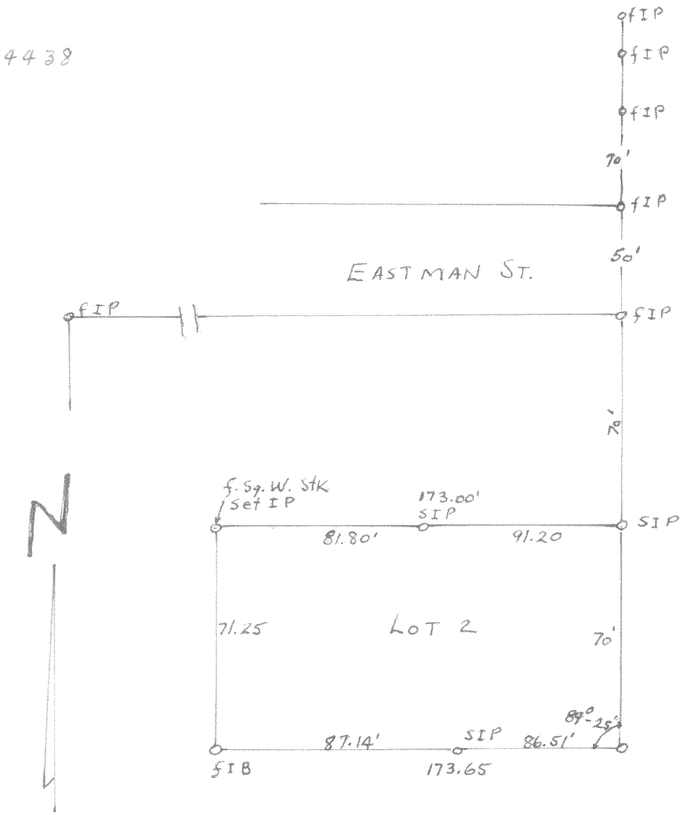

Survey of Lot 2 of Block 4 of Zenda

June 1963

Floyd F Iverson
County Surveyor