

#2870

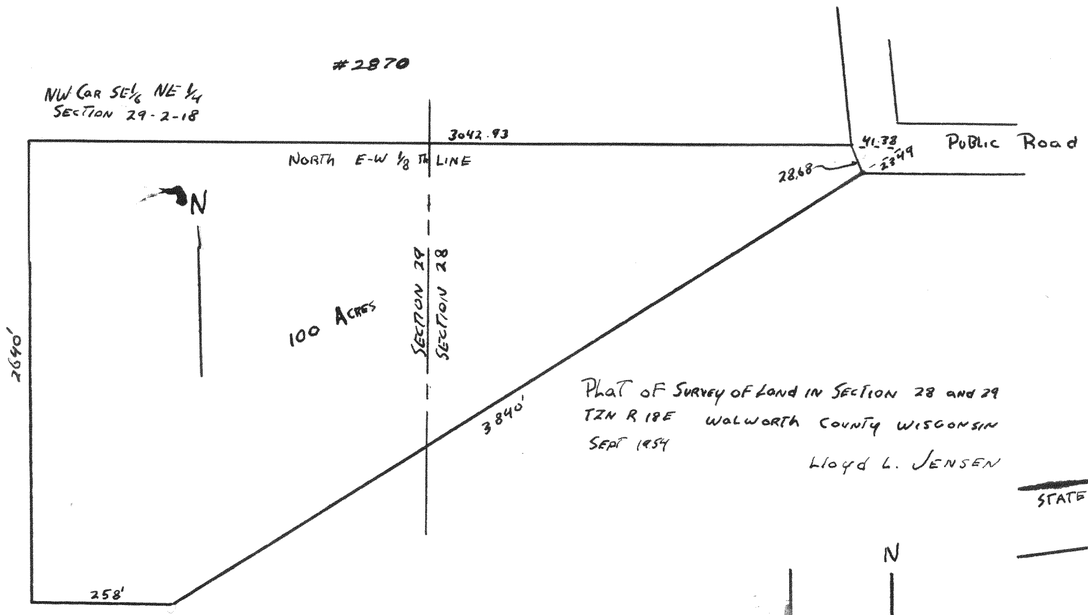


Plat of Survey of Land in Section 28 and 29
T1N R 18E Walworth County Wisconsin
Sept 1954
Lloyd L. Jensen

#2871

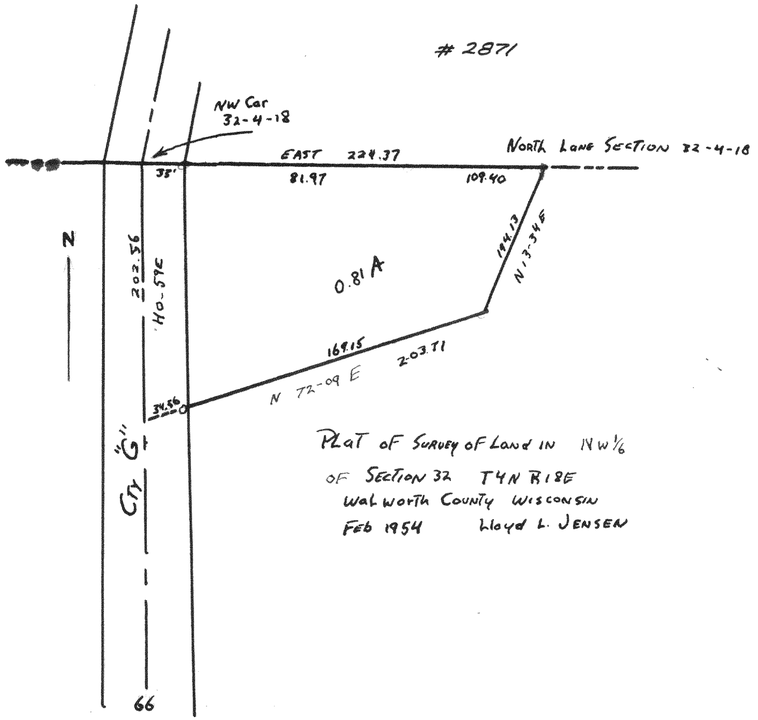


Plat of Survey of Land in NW⅙
of Section 32 T4N R18E
Walworth County Wisconsin
Feb 1954 Lloyd L. Jensen

#2872

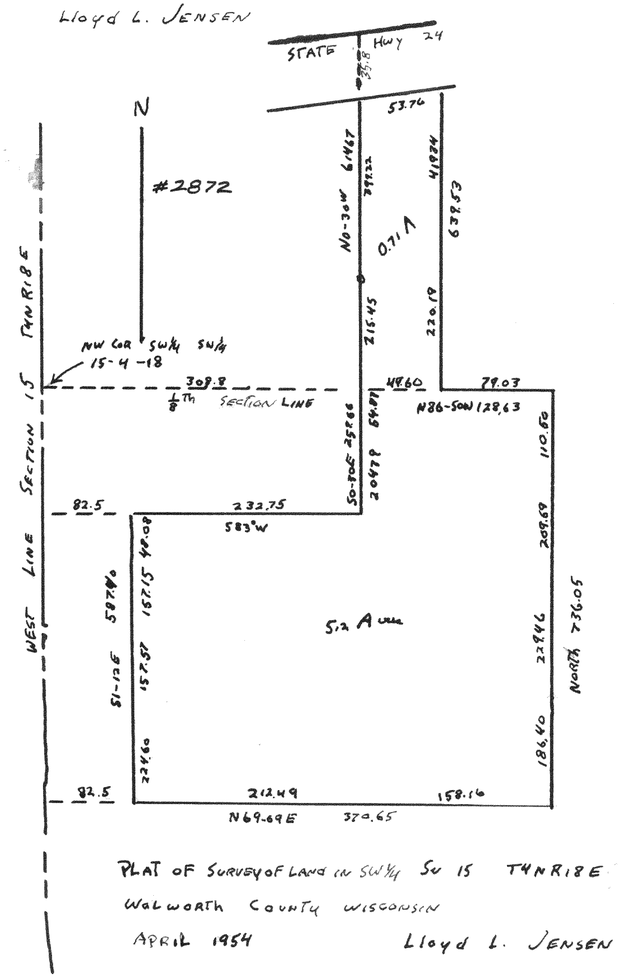

Plat of Survey of Land in SW¼ Su 15 T4N R18E
Walworth County Wisconsin
April 1954 Lloyd L. Jensen

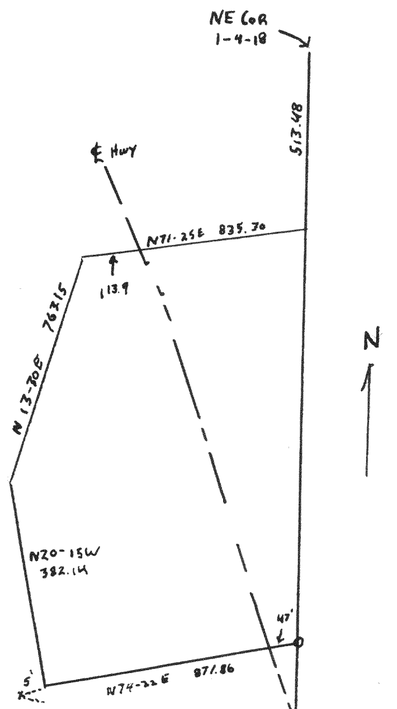

Plat of Survey of Land in
NE ¼ Section 1 T4N R18E
1954 #2873