
#4444

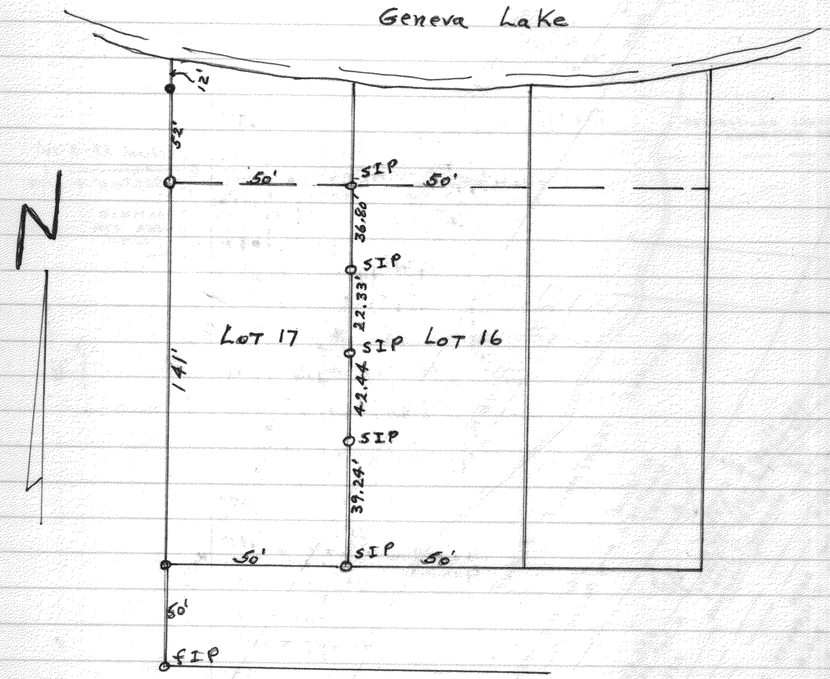

Plat of survey of Lot line between Lots 16+17 of Lake Geneva Highlands.

April 21, 1962

Lloyd L Jensen
County Surveyor

#4445

PLAT OF SURVEY OF
LOT 1, BLOCK 16 ORIGINAL PLAT
VILLAGE OF MUKWONAGO, WAUKESHA
COUNTY, WISCONSIN.

MARCH 7, 1964
MAY 18, 1964

Lloyd L Jensen
SURVEYOR

NOTE:
CHECK WATER DEPT. FOR RECENT WATER MAIN INSTALLATION ON WEST PART OF MAIN STREET. CHECK VILLAGE BUILDING INSPECTOR FOR CURRENT ZONING AND BUILDING CODE.

