

#4448

PLAT OF SURVEY OF
LOT 41, BLK 2, SWIFT LAKE
SUBDIVISION S½ SECTION 8,
T4N, R17E WALCO, WIS.
JULY 1963

Floyd F Jensen
CO. SURVEYOR

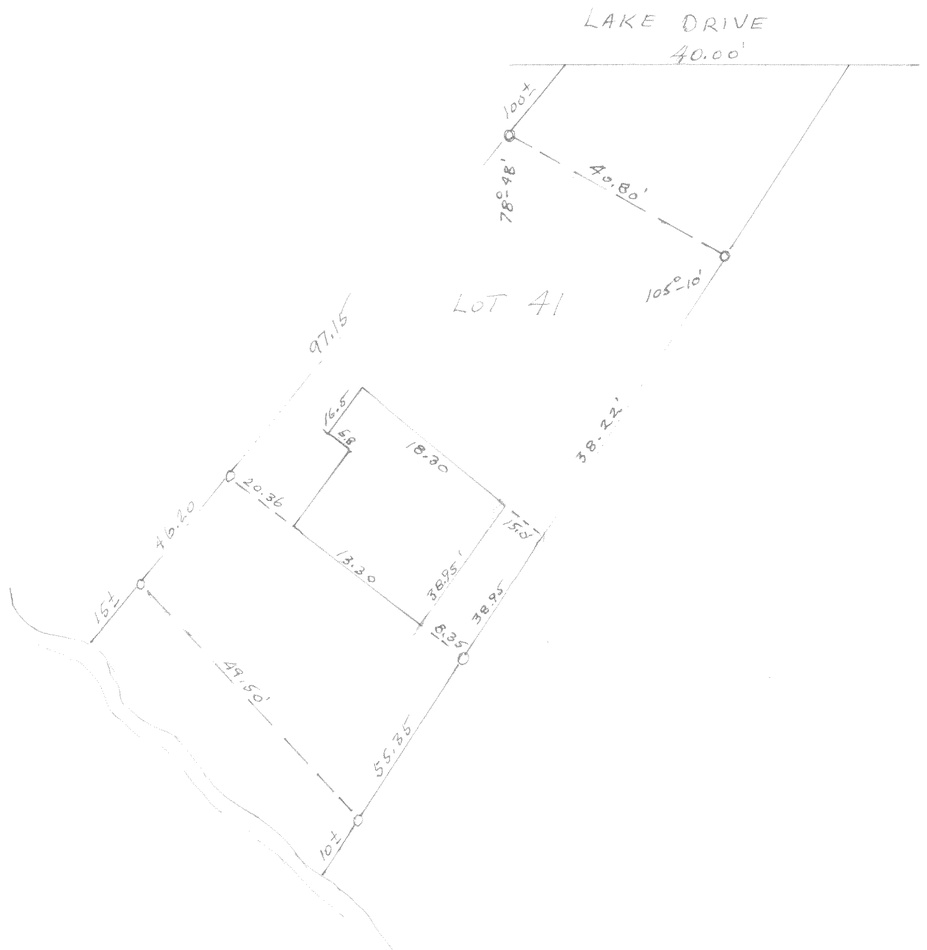

#4449

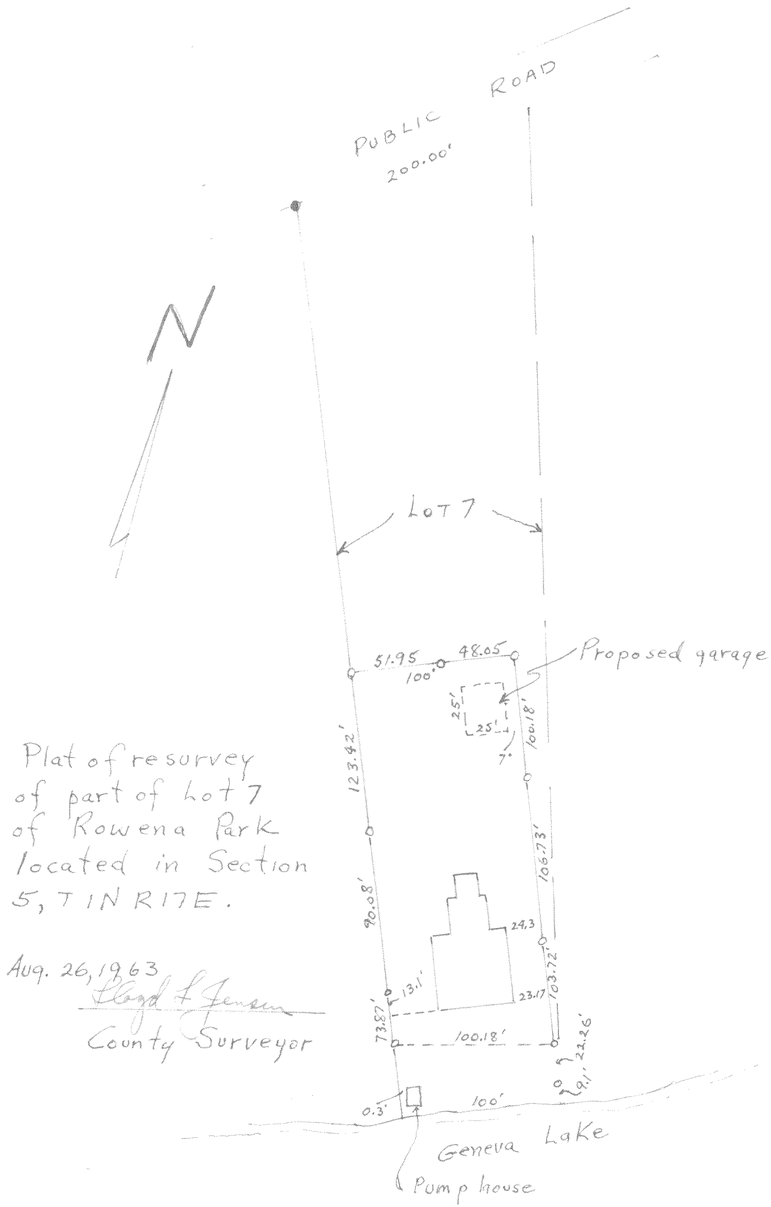

Plat of resurvey
of part of lot 7
of Rowena Park
located in Section
5, T1N R17E.

Aug. 26, 1963

Floyd F Jensen
County Surveyor