
#4450

PLAT OF SURVEY OF
U.P. 159 NW¼ SEC. 5
TAN RISE CITY OF
WHITEWATER, WAL. CO. WIS.
JUNE 1962


Floyd F. Jensen
CO. SURVEYOR

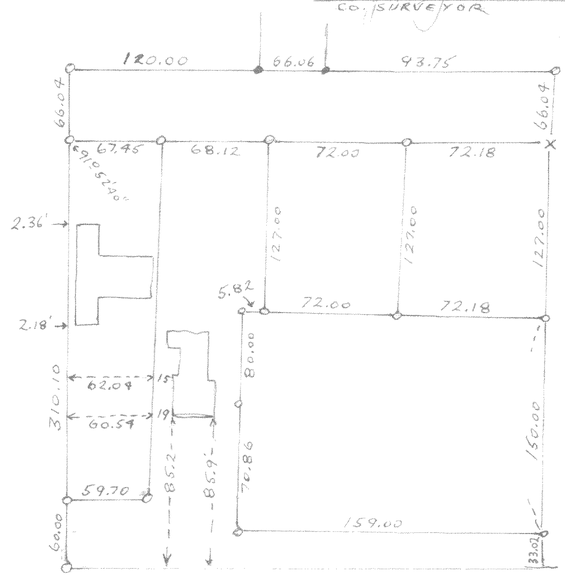

1 2

#4451 PLAT OF SURVEY OF
LAND LOCATED IN CONGER
SUBD. WHITEWATER, WAL. CO. WIS.
1964

Floyd F. Jensen
CO. SURVEYOR

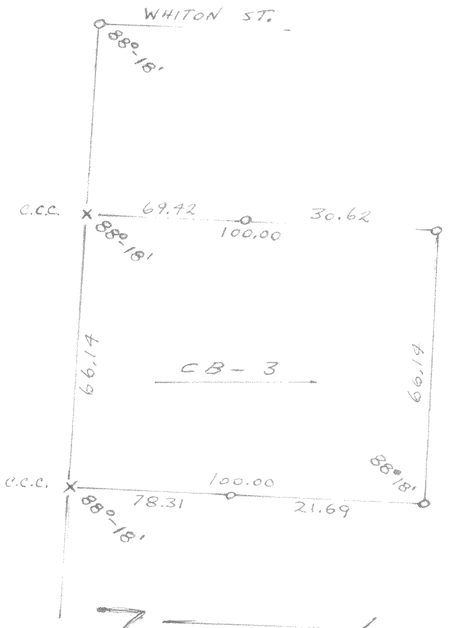

2 1