

588 # 4455

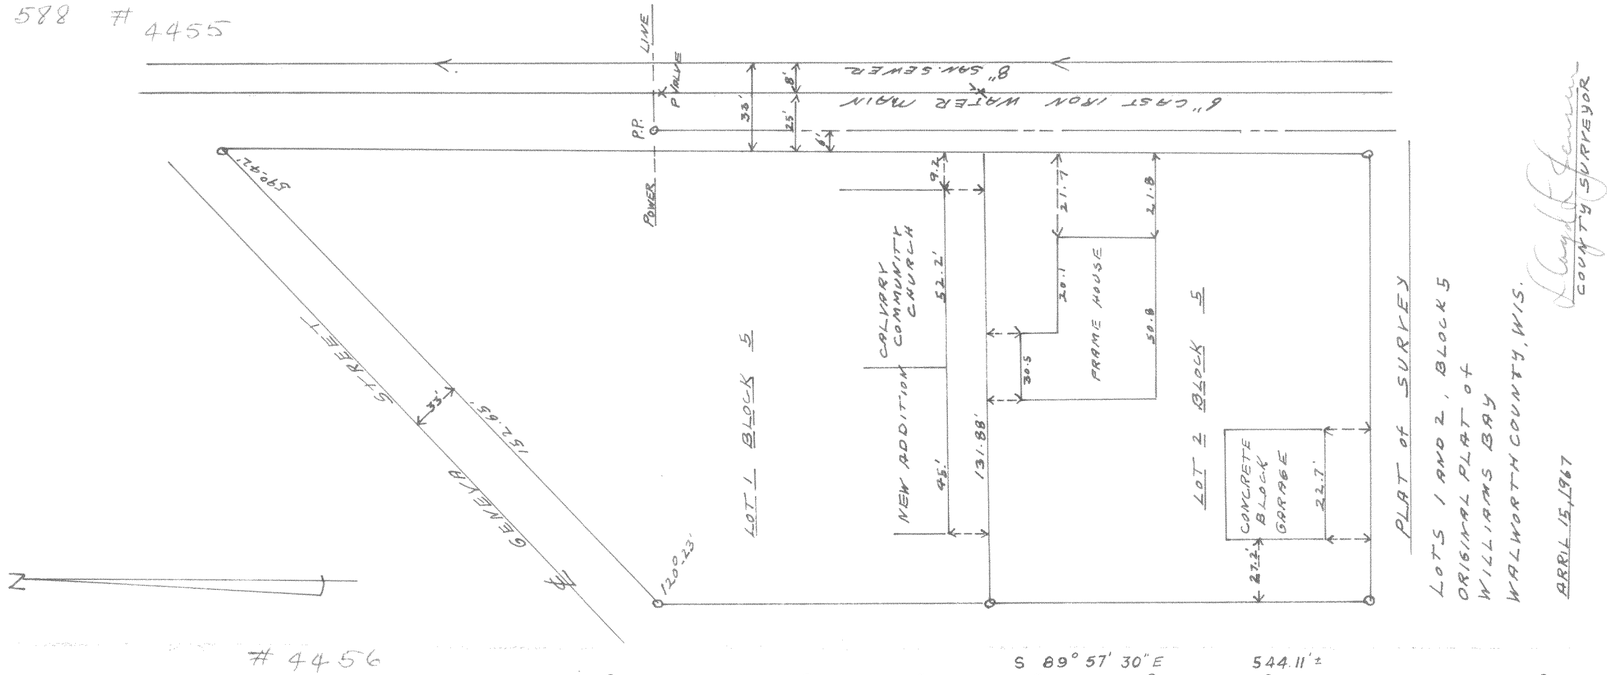

4456

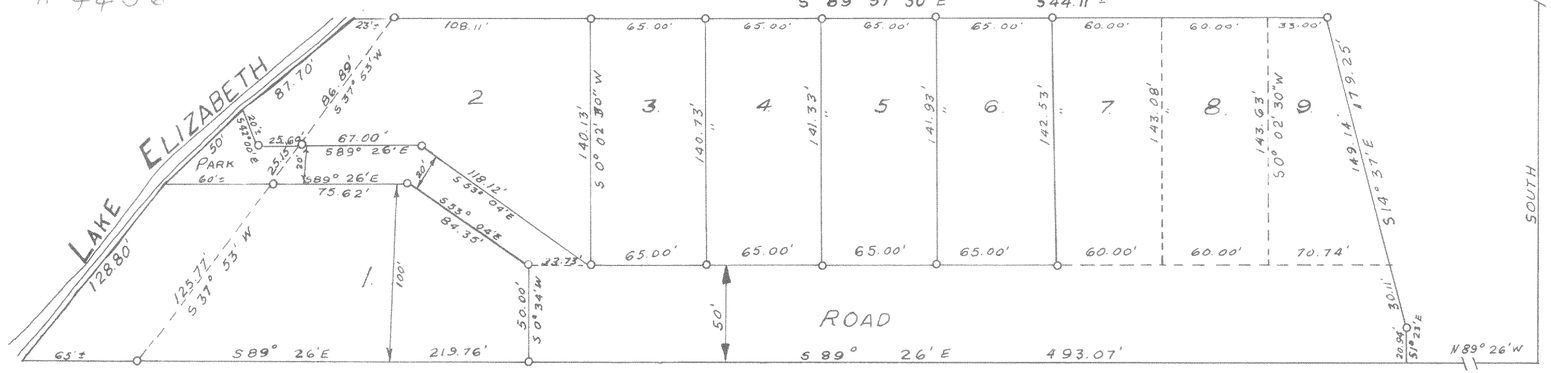

O – DENOTES IRON PIPE

N

NW ¼ SECTION 33 T 1N R 19E
KENOSHA COUNTY, WISCONSIN

PLAT OF SURVEY

Lloyd L. Jensen
SURVEYOR

AUGUST 1966