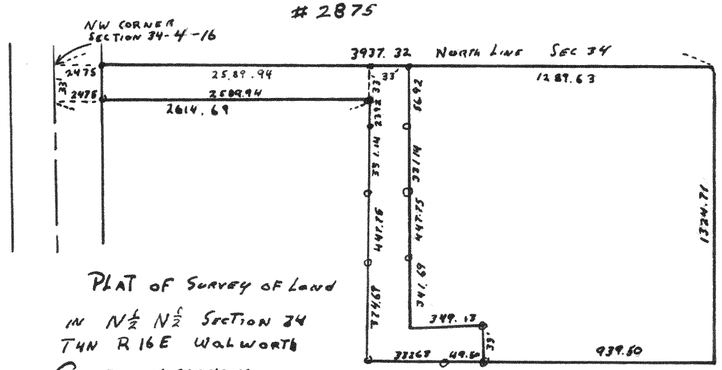
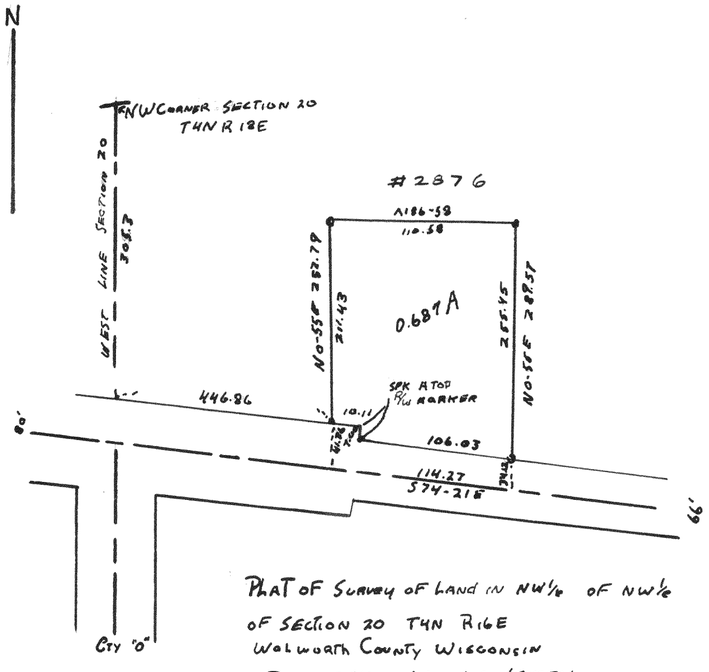
## #2875



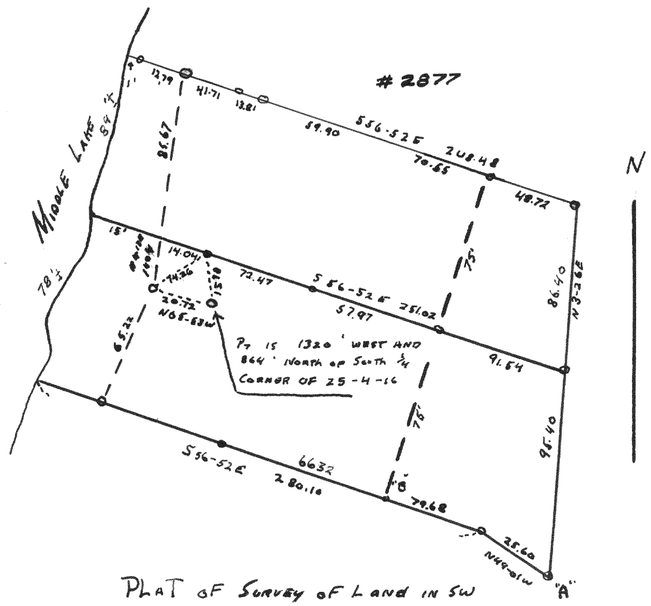

PLAT of Survey of Land
in N½ N½ Section 34
T4N R16E Walworth
County Wisconsin
March 1954 Lloyd L Jensen

## #2876



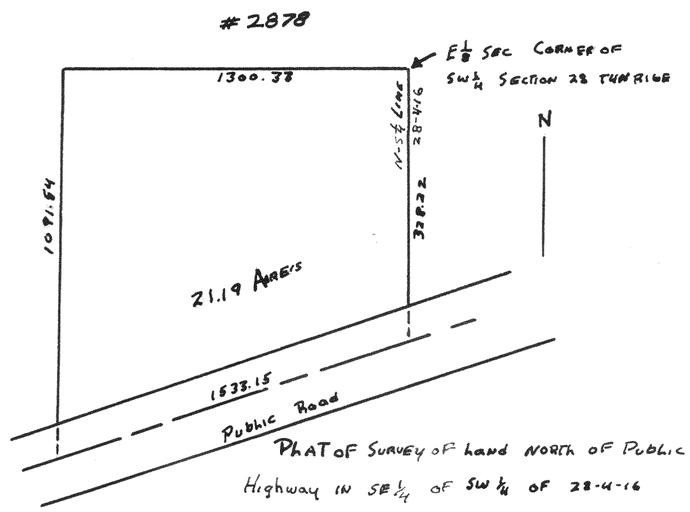

PLAT of Survey of Land in NW¼ of NW¼
of Section 20 T4N R16E
Walworth County Wisconsin
Dec 1954 Lloyd L Jensen

## #2877




PLAT of Survey of Land in SW
Fr ¼ Section 25 T4N R16E
Walworth County Wisconsin
Aug 1954 Lloyd L Jensen

## #2878




PLAT of Survey of land North of Public
Highway in SE¼ of SW¼ of 28-4-16
Walworth County Wisconsin
Dec 1954 Lloyd L Jensen

## #2879

PLAT of Survey of Part of NE¼ of NE¼
Section 33 T4N R16E Walworth
County Wisconsin
Dec. 1954 Lloyd L Jensen

