
2633

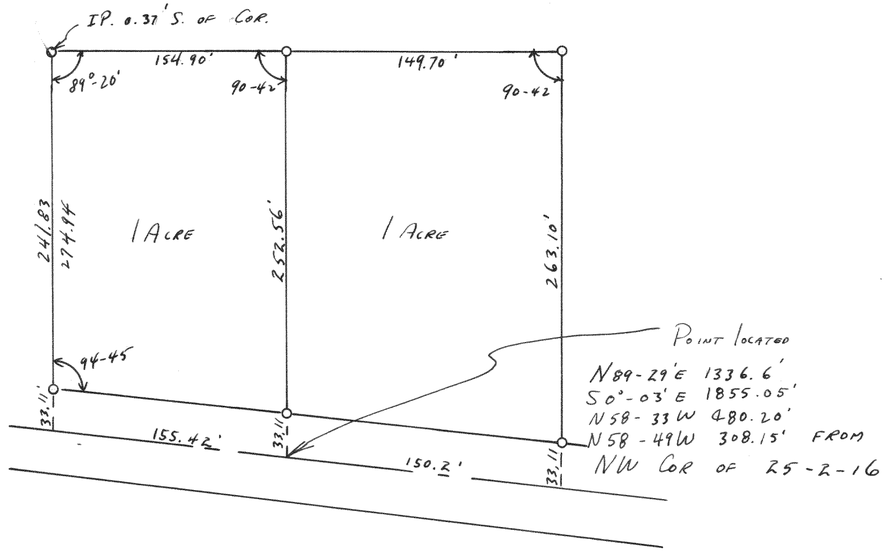


Plat of survey of 2 - 1 acre parcels of land in Section 25, T2N R16E.

May 1952

Lloyd L Jensen
County Surveyor CRS.

2634

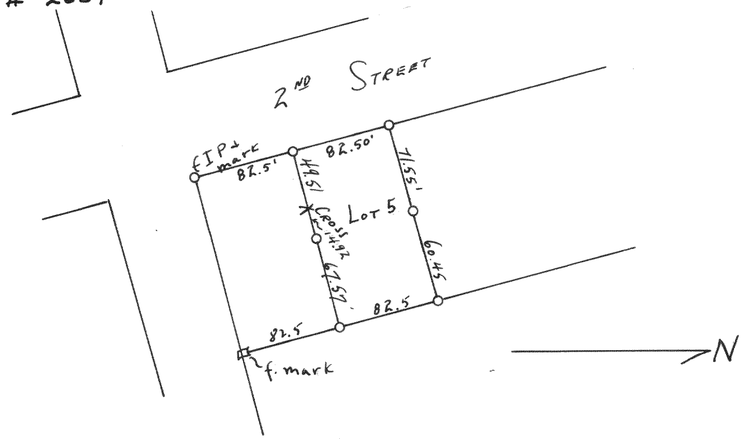


Plat of survey of Lot 5 of Block 1 of the original plat of the Village of Darien.

Aug 6, 1952

Lloyd L Jensen
County Surveyors CRS.

2635

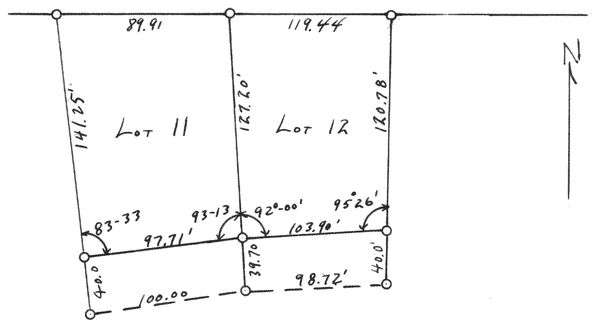


Plat of survey of Lots 11 and 12 of Delavan Country Club Subdivision.

Aug 8, 1952

Lloyd L. Jensen
County Surveyor CRS.

2636

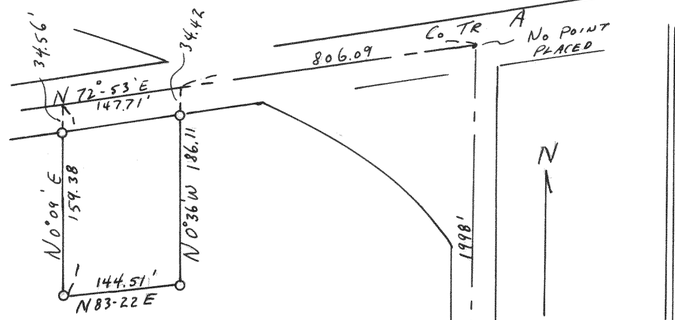


Plat of survey of a parcel of land located in Section 17, T3N R15E of Walworth County Wisconsin.

July 30, 1952

Lloyd L. Jensen
County Surveyor CRS.

SE cor Sec. 17-3-15

2637

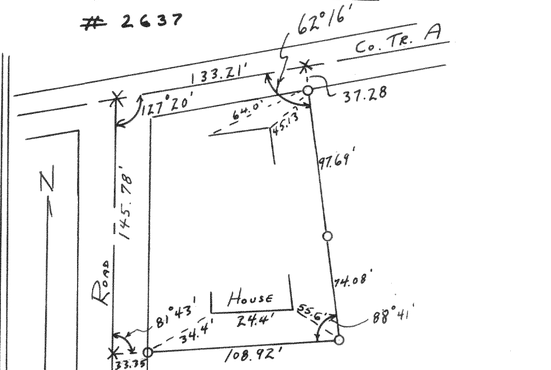

Plat of a survey of a parcel of land in the NW¼ of Section 15, T3N R15E of Walworth County.

June 1952

Lloyd L. Jensen
County Surveyor CRS.