

#2880

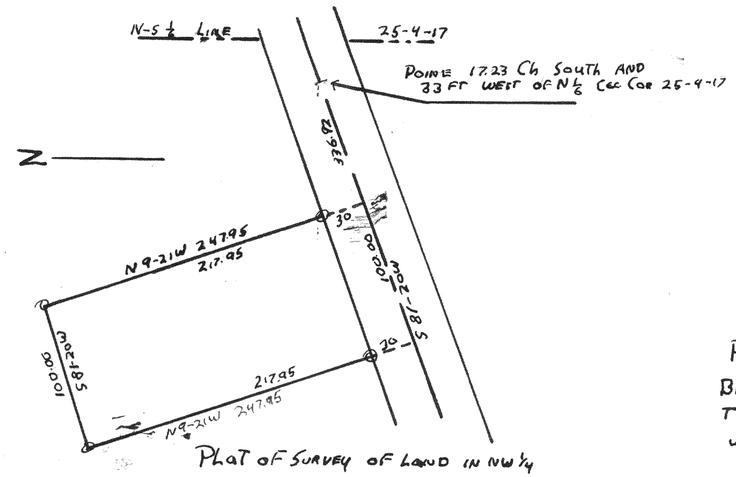


Plat of Survey of Land in NW¼
Section 25 T4N R18E
Walworth County Wisconsin
July 1954 LLJ CS

#2881

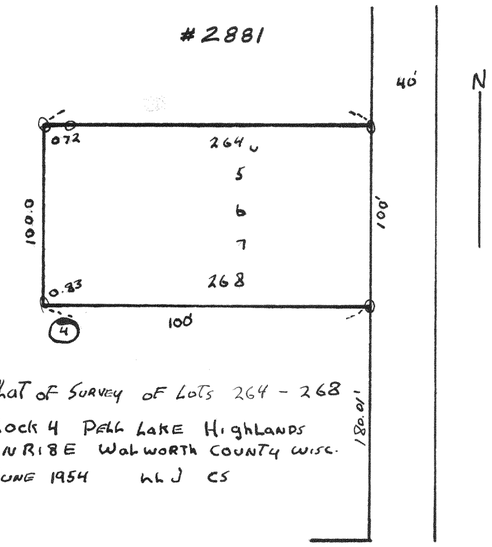


Plat of Survey of Lots 264 - 268
Block 4 Pell Lake Highlands
T1N R18E Walworth County Wisc.
June 1954 LLJ CS

#2882

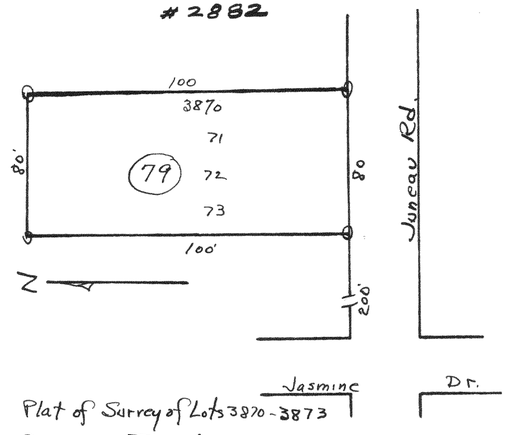


Plat of Survey of Lots 3870-3873
Block 79 Pell Lake T1N R18E
Walworth County, Wis
July 1954 Lloyd J. Jensen C.S.

#2883

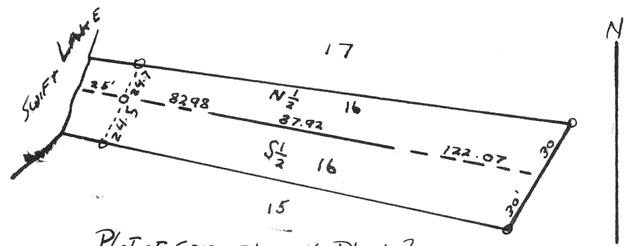

Plat of Survey of Land 16 Block 2
Swift Lake Subdivision T4N R18E
Walworth County Wisconsin
June 1954 LLJ CS

#2884

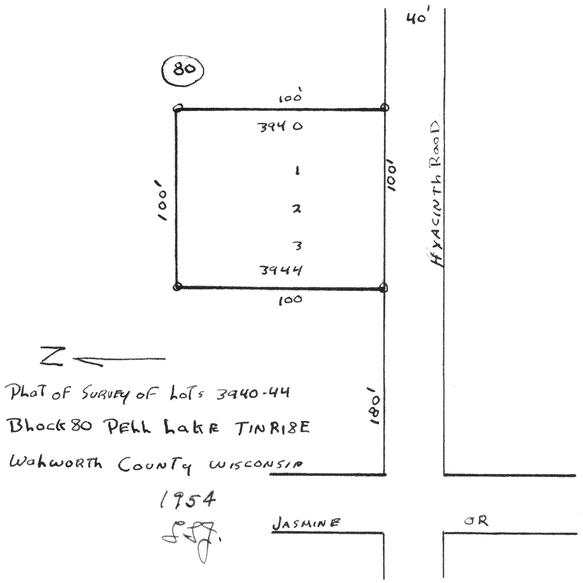

Plat of Survey of Lots 3940-44
Block 80 Pell Lake T1N R18E
Walworth County Wisconsin
1954

#2885

Plat of Survey of Lots 5514 - 5523
Block 101 Pell Lake T1N R18E
Walworth County Wisconsin
July 54 LLJ CS

