6-c 4

7-4476

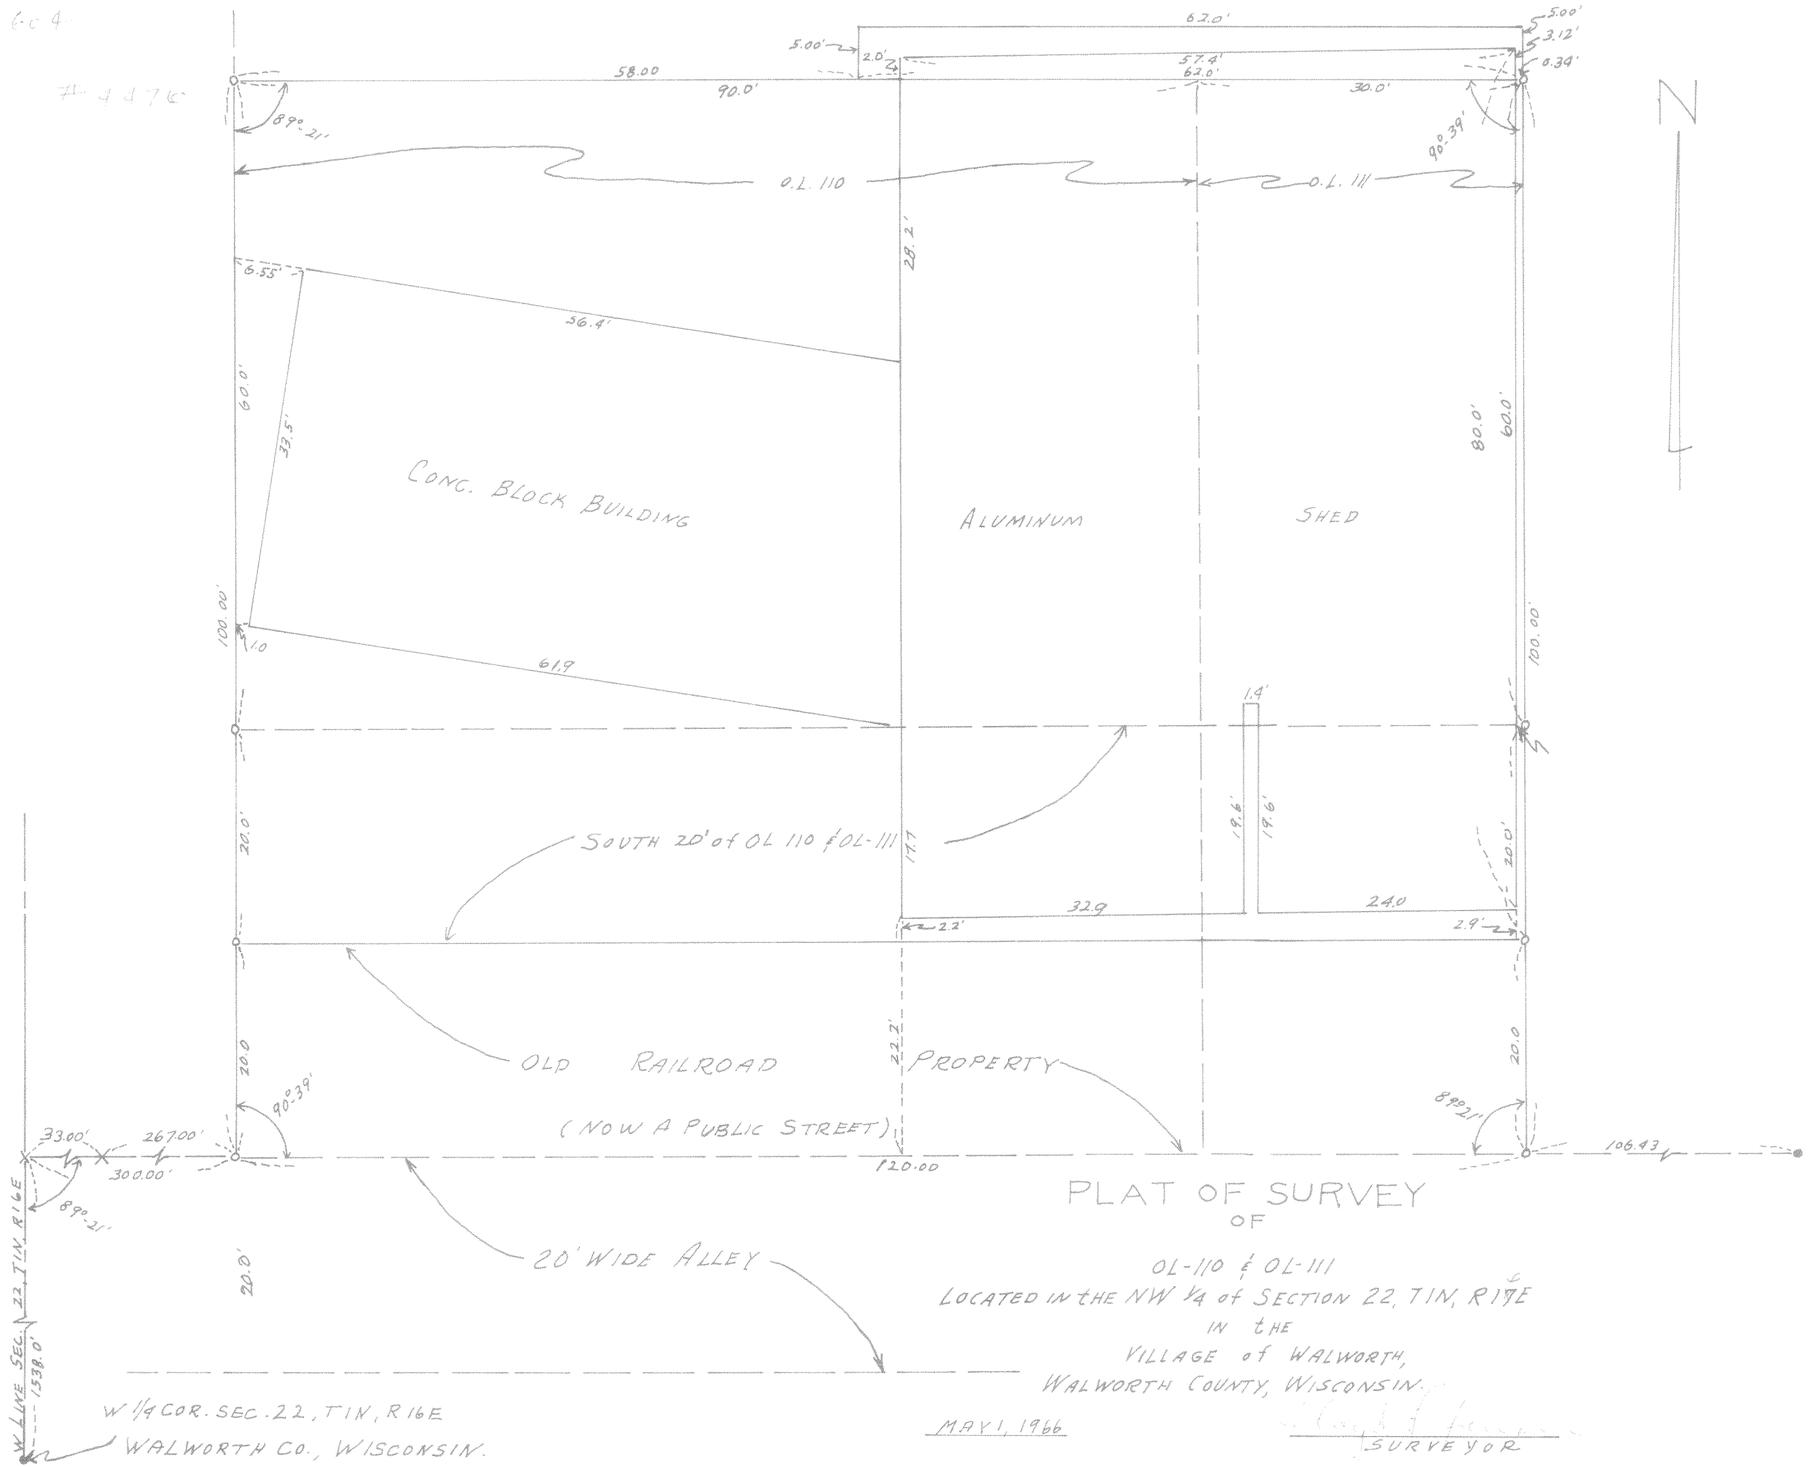

PLAT OF SURVEY
OF

OL-110 & OL-111
LOCATED IN THE NW 1/4 of SECTION 22, T1N, R16E
IN THE
VILLAGE of WALWORTH,
WALWORTH COUNTY, WISCONSIN.

MAY 1, 1966

SURVEYOR