
606

44-79

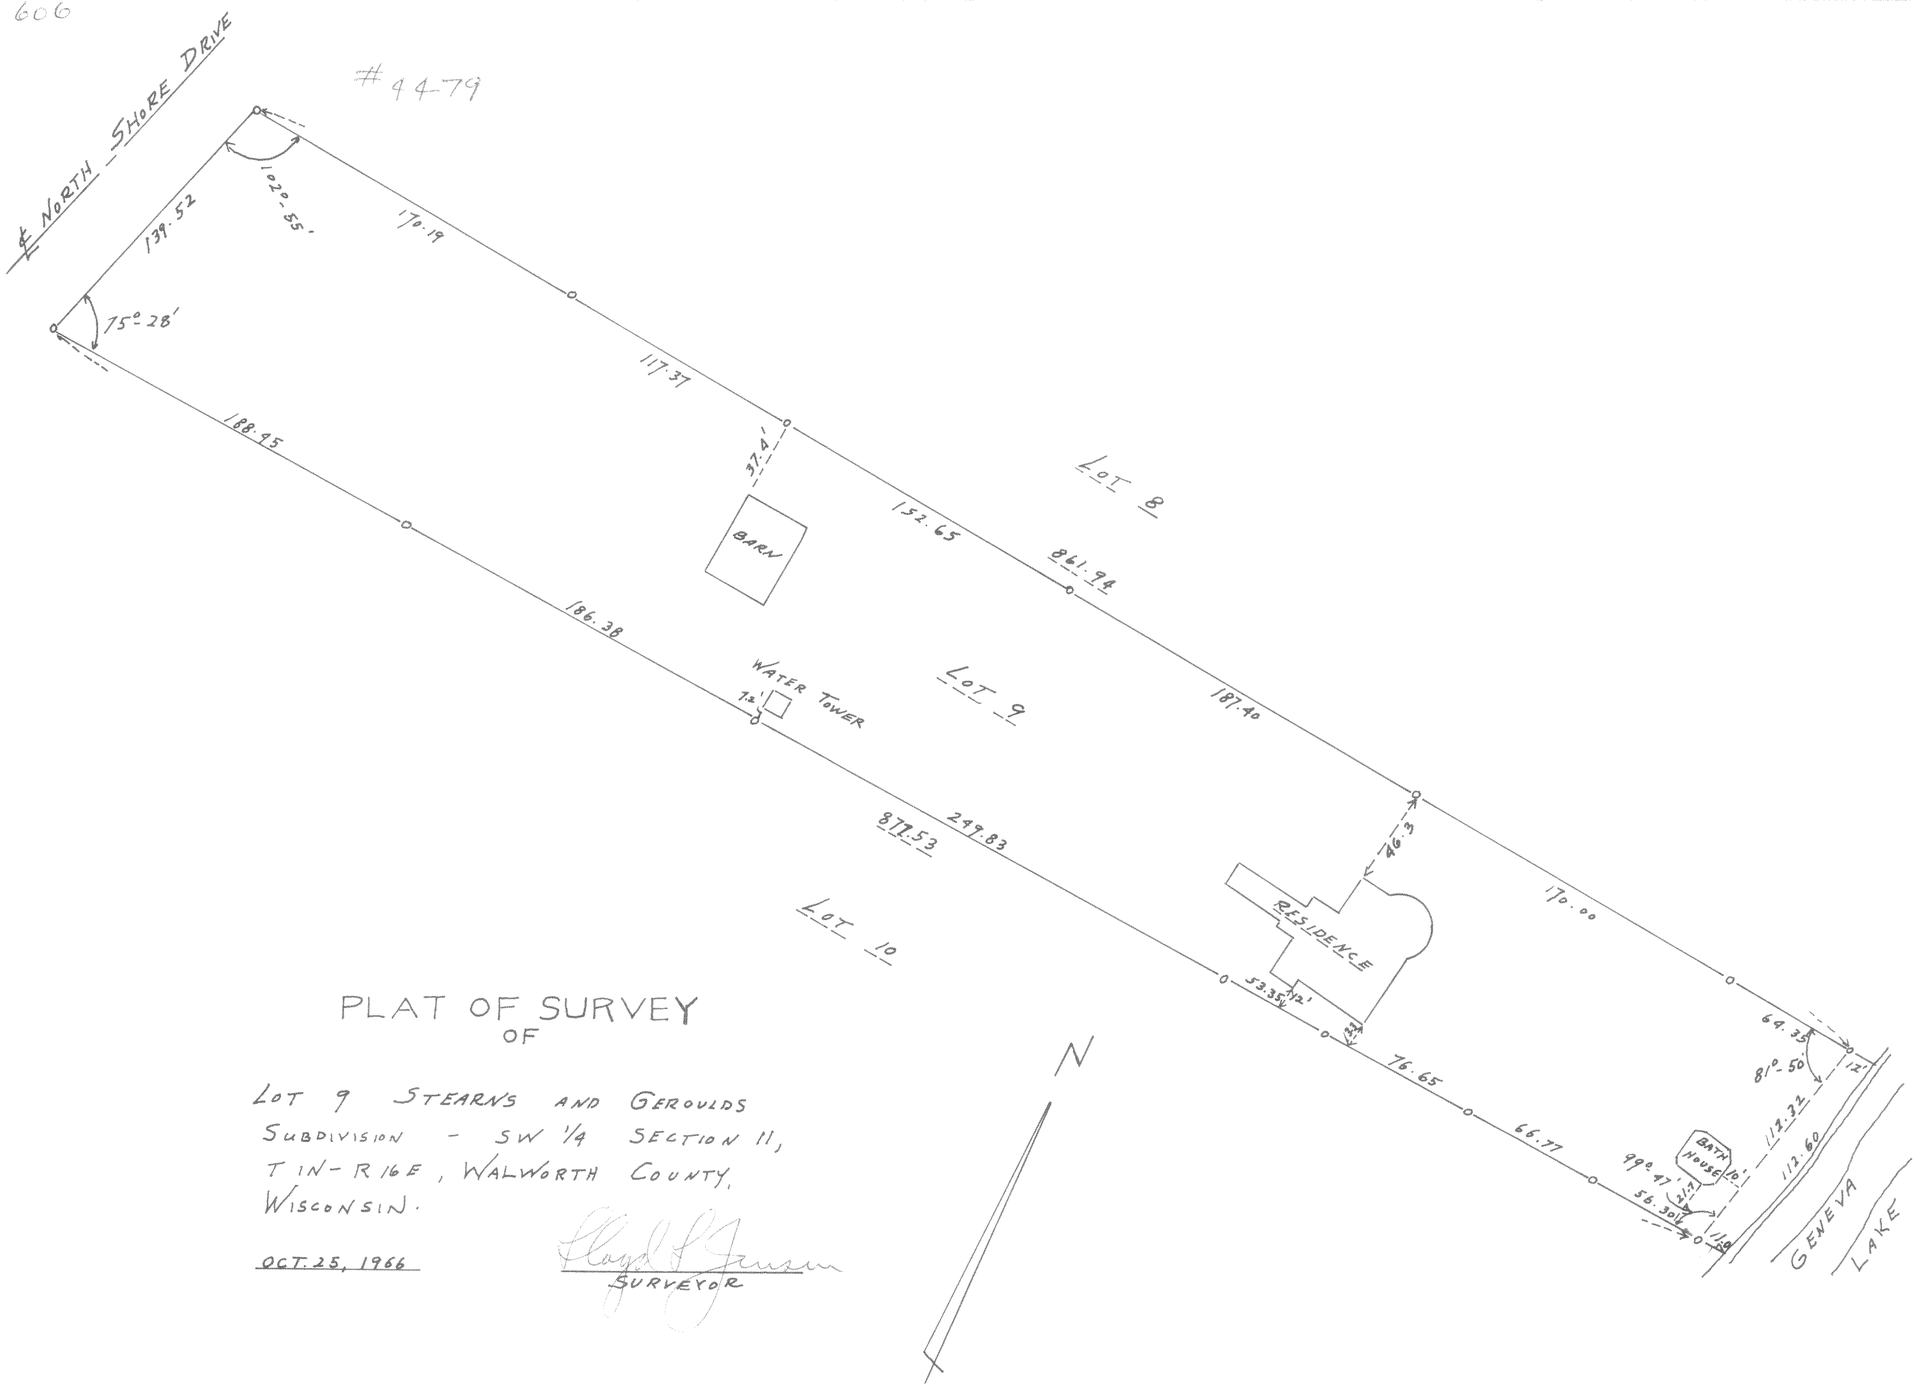

PLAT OF SURVEY
OF

LOT 9 STEARNS AND GEROULDS SUBDIVISION - SW 1/4 SECTION 11, T 1N - R 16 E, WALWORTH COUNTY, WISCONSIN.

OCT. 25, 1966

Floyd F. Jensen
SURVEYOR