
#4480

PLAT OF SURVEY
OF
LOT 185 AND LOT 185½
CEDAR POINT PARK SUBDIVISION
WILLIAMS BAY, WISCONSIN.

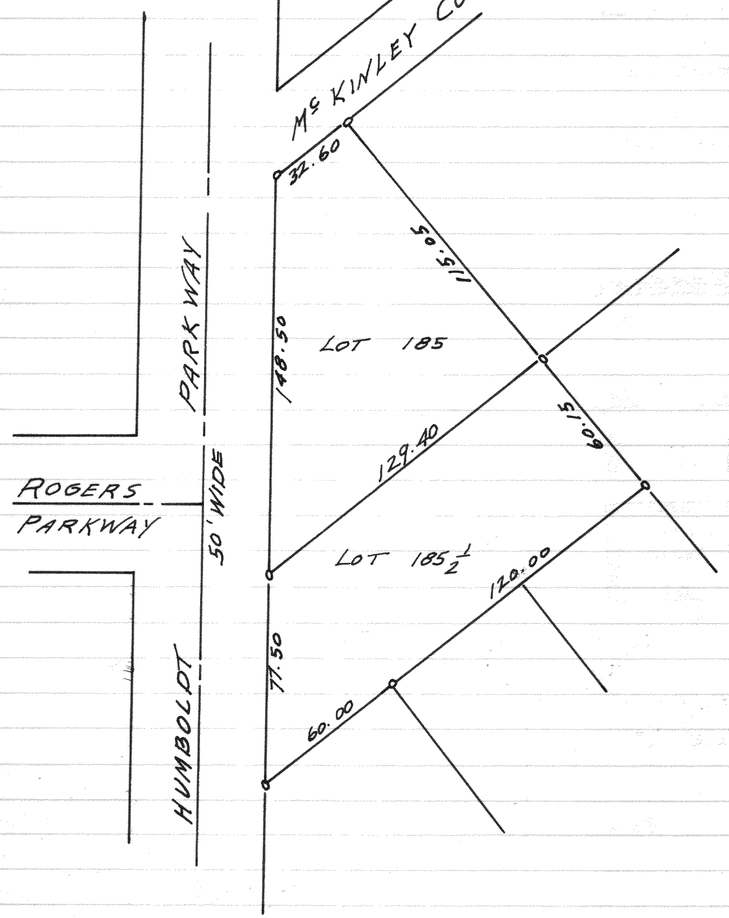


AUG. 1966

Floyd L Jensen
COUNTY SURVEYOR

#4481

PLAT OF SURVEY
OF
Lots 1-2-5-6 and
the North 15' Lot 9
of Fearons Subdivision
located in the NE 1/4
Section 24, T4N-R17E
Walworth County
Wisconsin.

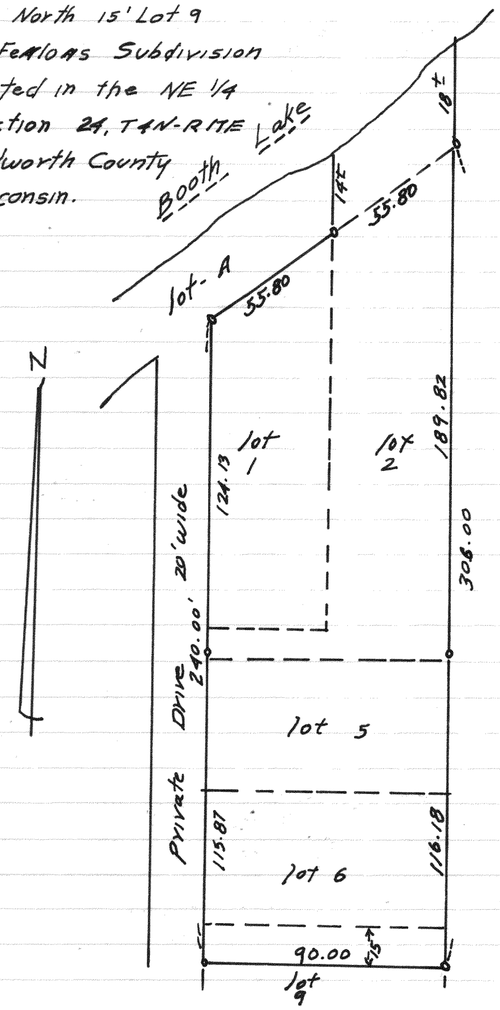

May 12, 1966

Floyd L Jensen
COUNTY SURVEYOR