
4484.

PLAT OF SURVEY
OF

LOTS 9274 - 9275 - 9276 - 9277 - 9278
PELL LAKE SUBDIVISION
SECTION 15, T1N - R18E
WALWORTH COUNTY, WISCONSIN.

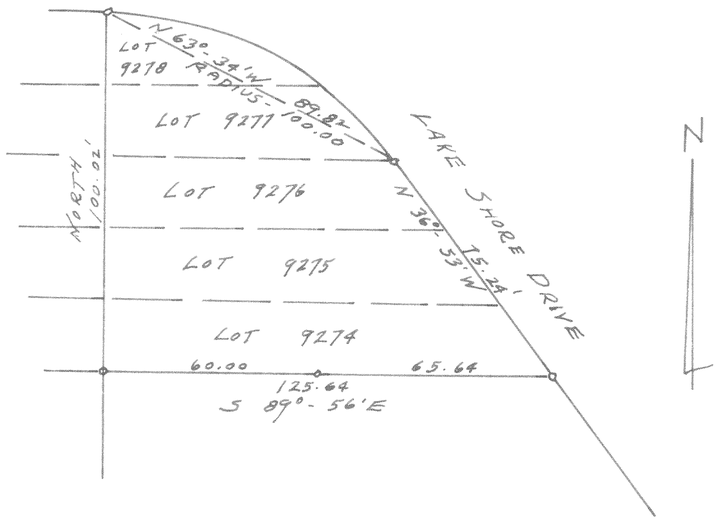


NOV. 1966

Floyd L Jensen
COUNTY SURVEYOR

4485

PLAT OF SURVEY
OF

LOT 26 - 27 - 28 LOST NATION PARK SUBDIVISION, NE 1/4 SECTION 35, T4N - R16E, WALWORTH COUNTY, WIS

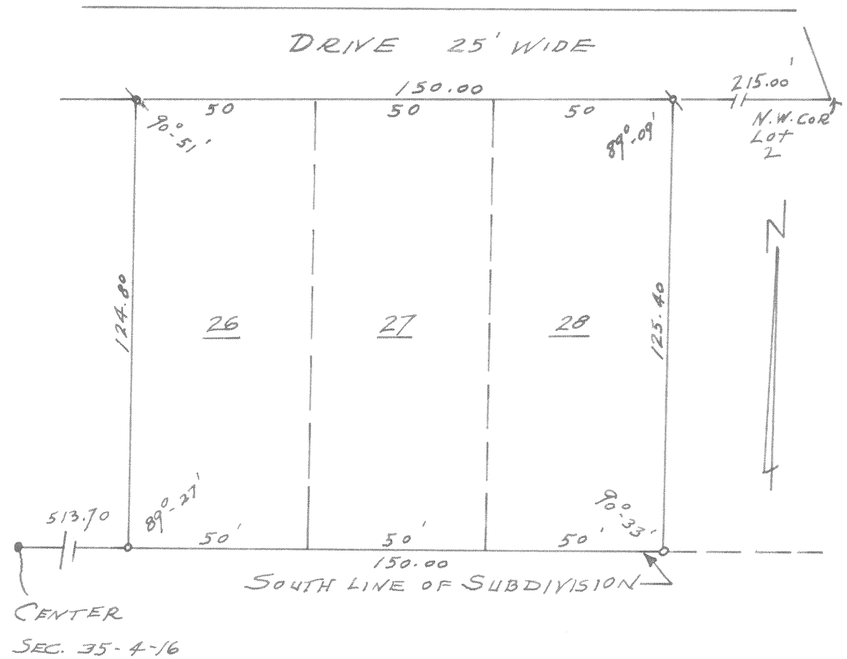

NOV. 1966

Floyd L Jensen
COUNTY SURVEYOR