

#2886

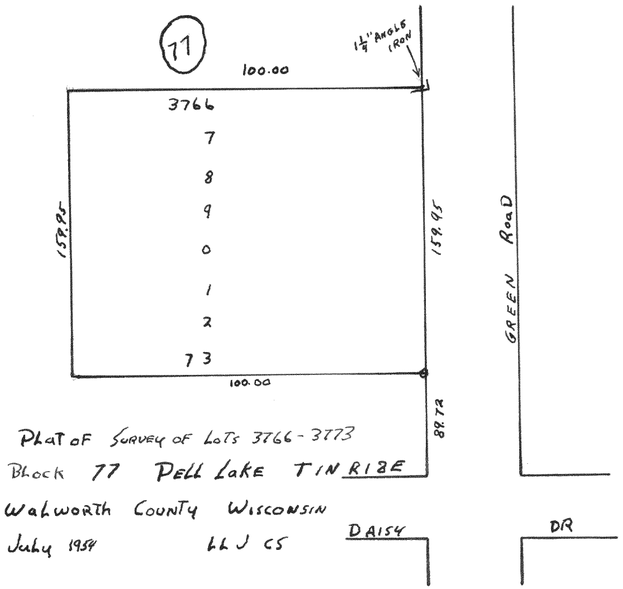


Plat of Survey of Lots 3766-3773
Block 77 Pell Lake T1N R13E
Walworth County Wisconsin
July 1954 LLJ CS


#2887

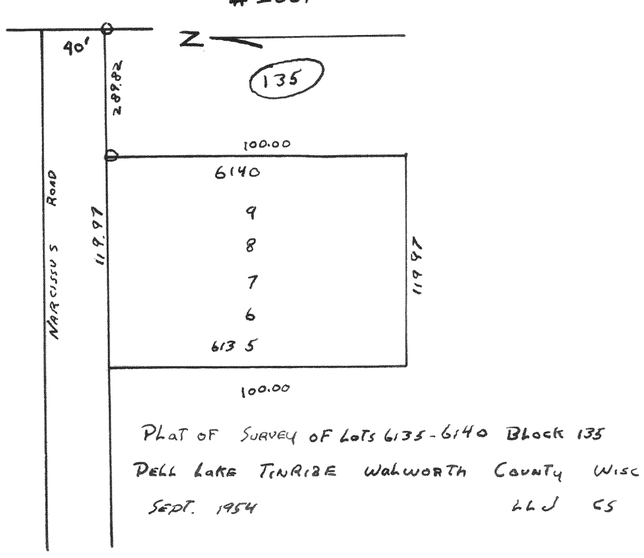

Plat of Survey of Lots 6135-6140 Block 135
Pell Lake T1N R13E Walworth County Wisc
Sept. 1954 LLJ CS

N

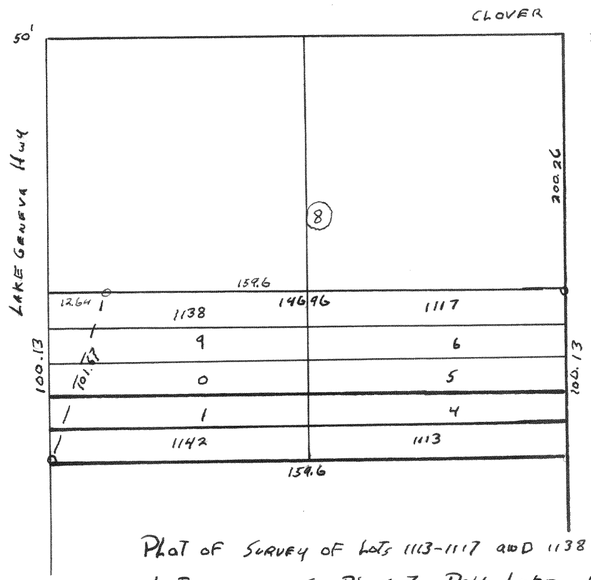


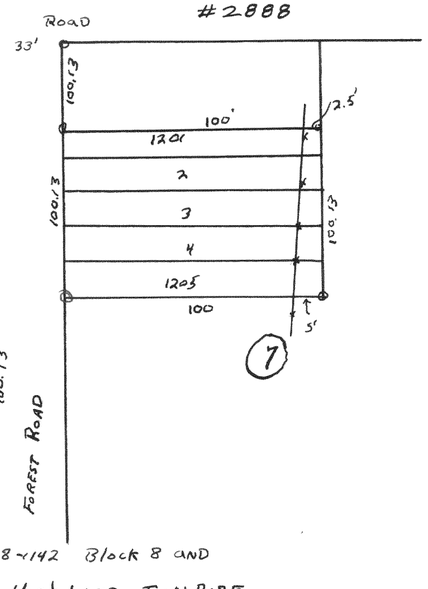

Plat of Survey of Lots 1113-1117 and 1138-1142 Block 8 and
Lots 1201-1205 Block 7 Pell Lake Highland T1N R13E
Walworth County Wisc
Nov 1954

LLJ
CS

#2889

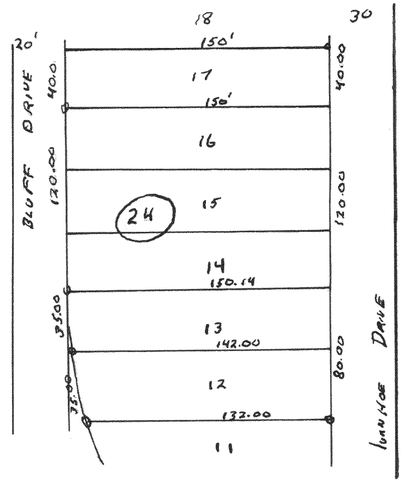

Plat of Survey of Lots 12,13 and 17 Block 24
Lake Ivanhoe Resort T1N R13E Walworth
County Wisconsin
Nov 1954

LLJ
CS