
614

#4491

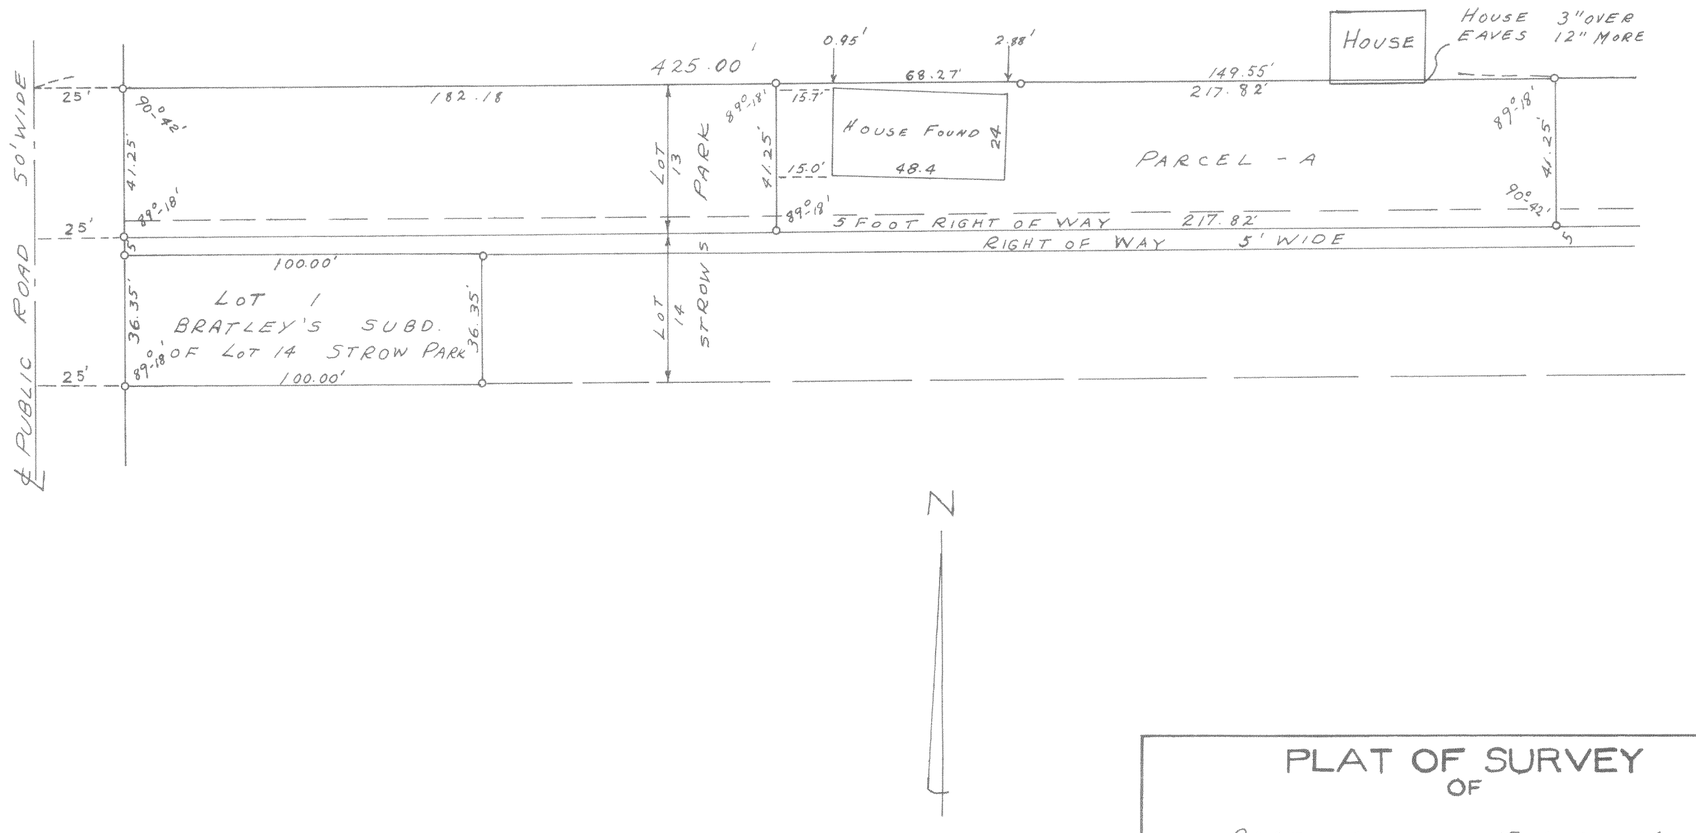

o - IRON STAKE

● - CONC. MON.

PLAT OF SURVEY
OF

PART OF LOTS 13 AND 14 OF STROWS PARK, SECTION 28, T 2N - R 16E, WALWORTH COUNTY, WISCONSIN.

Floyd L. Jones
SURVEYOR

SCALE 1" = 30'

DATE JUNE 1966