
4496

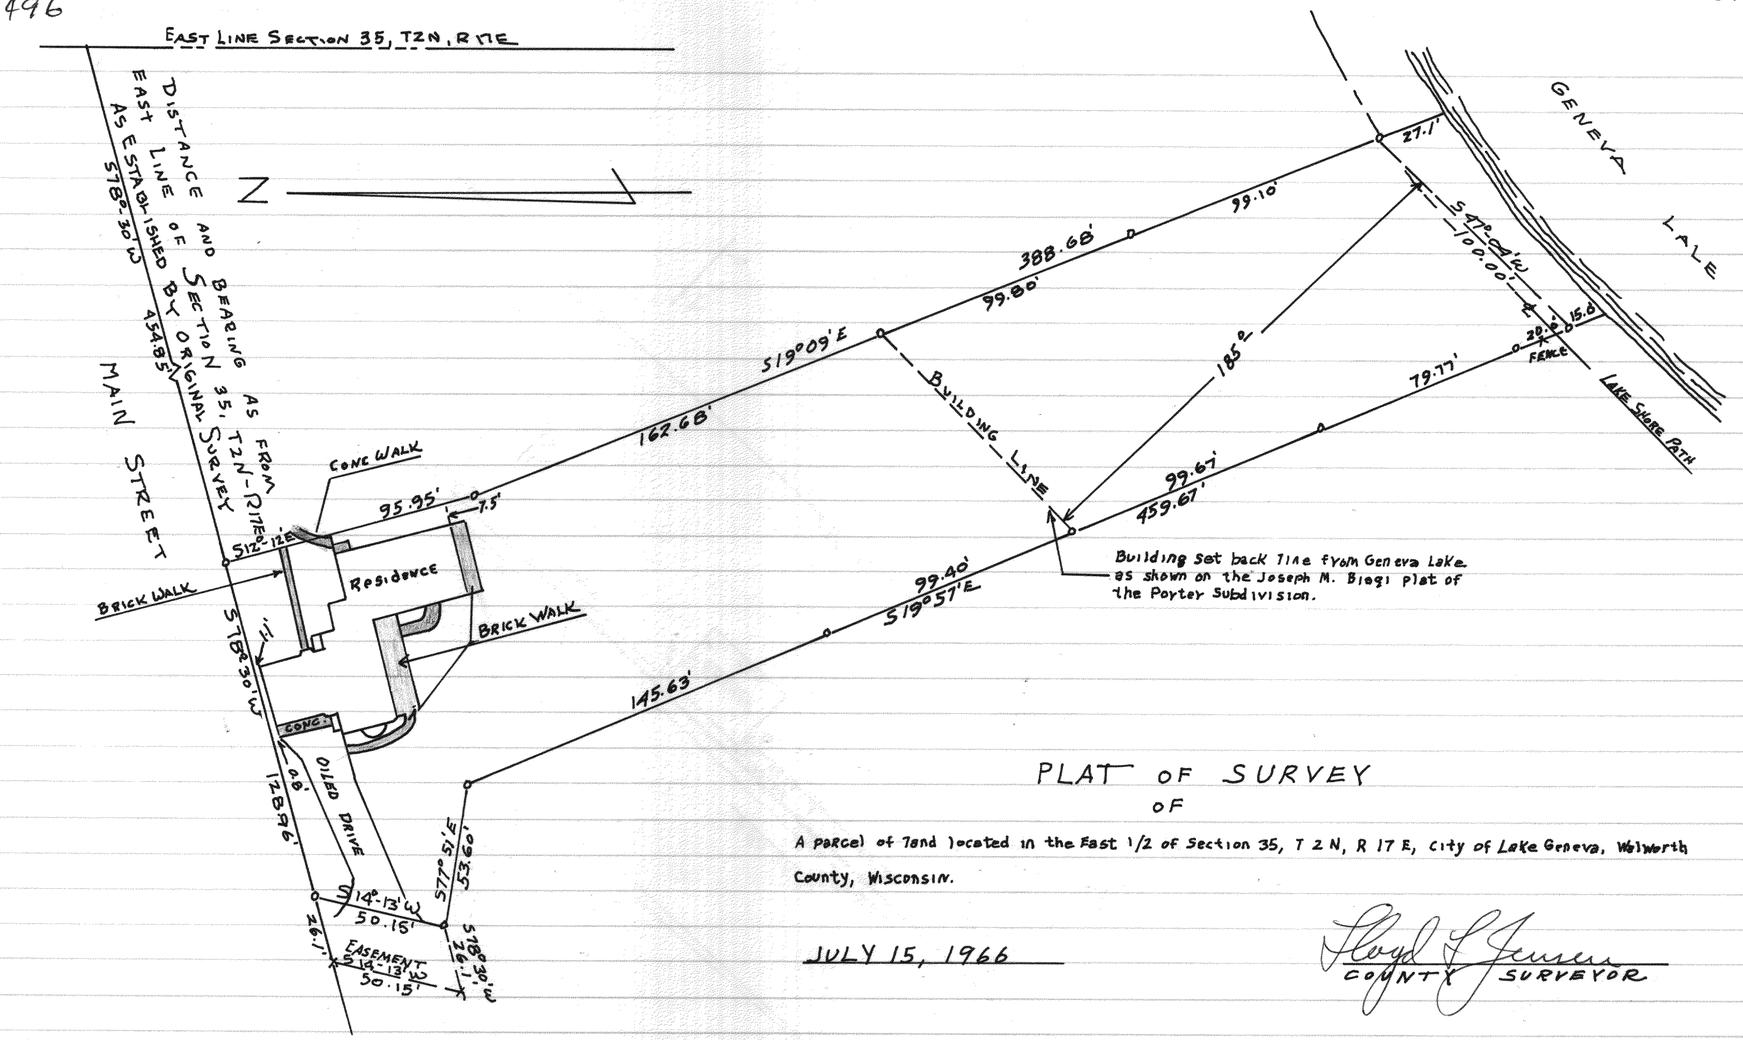

PLAT OF SURVEY
OF

A parcel of land located in the East 1/2 of Section 35, T 2 N, R 17 E, City of Lake Geneva, Walworth County, Wisconsin.

JULY 15, 1966

Floyd L. Jensen
COUNTY SURVEYOR