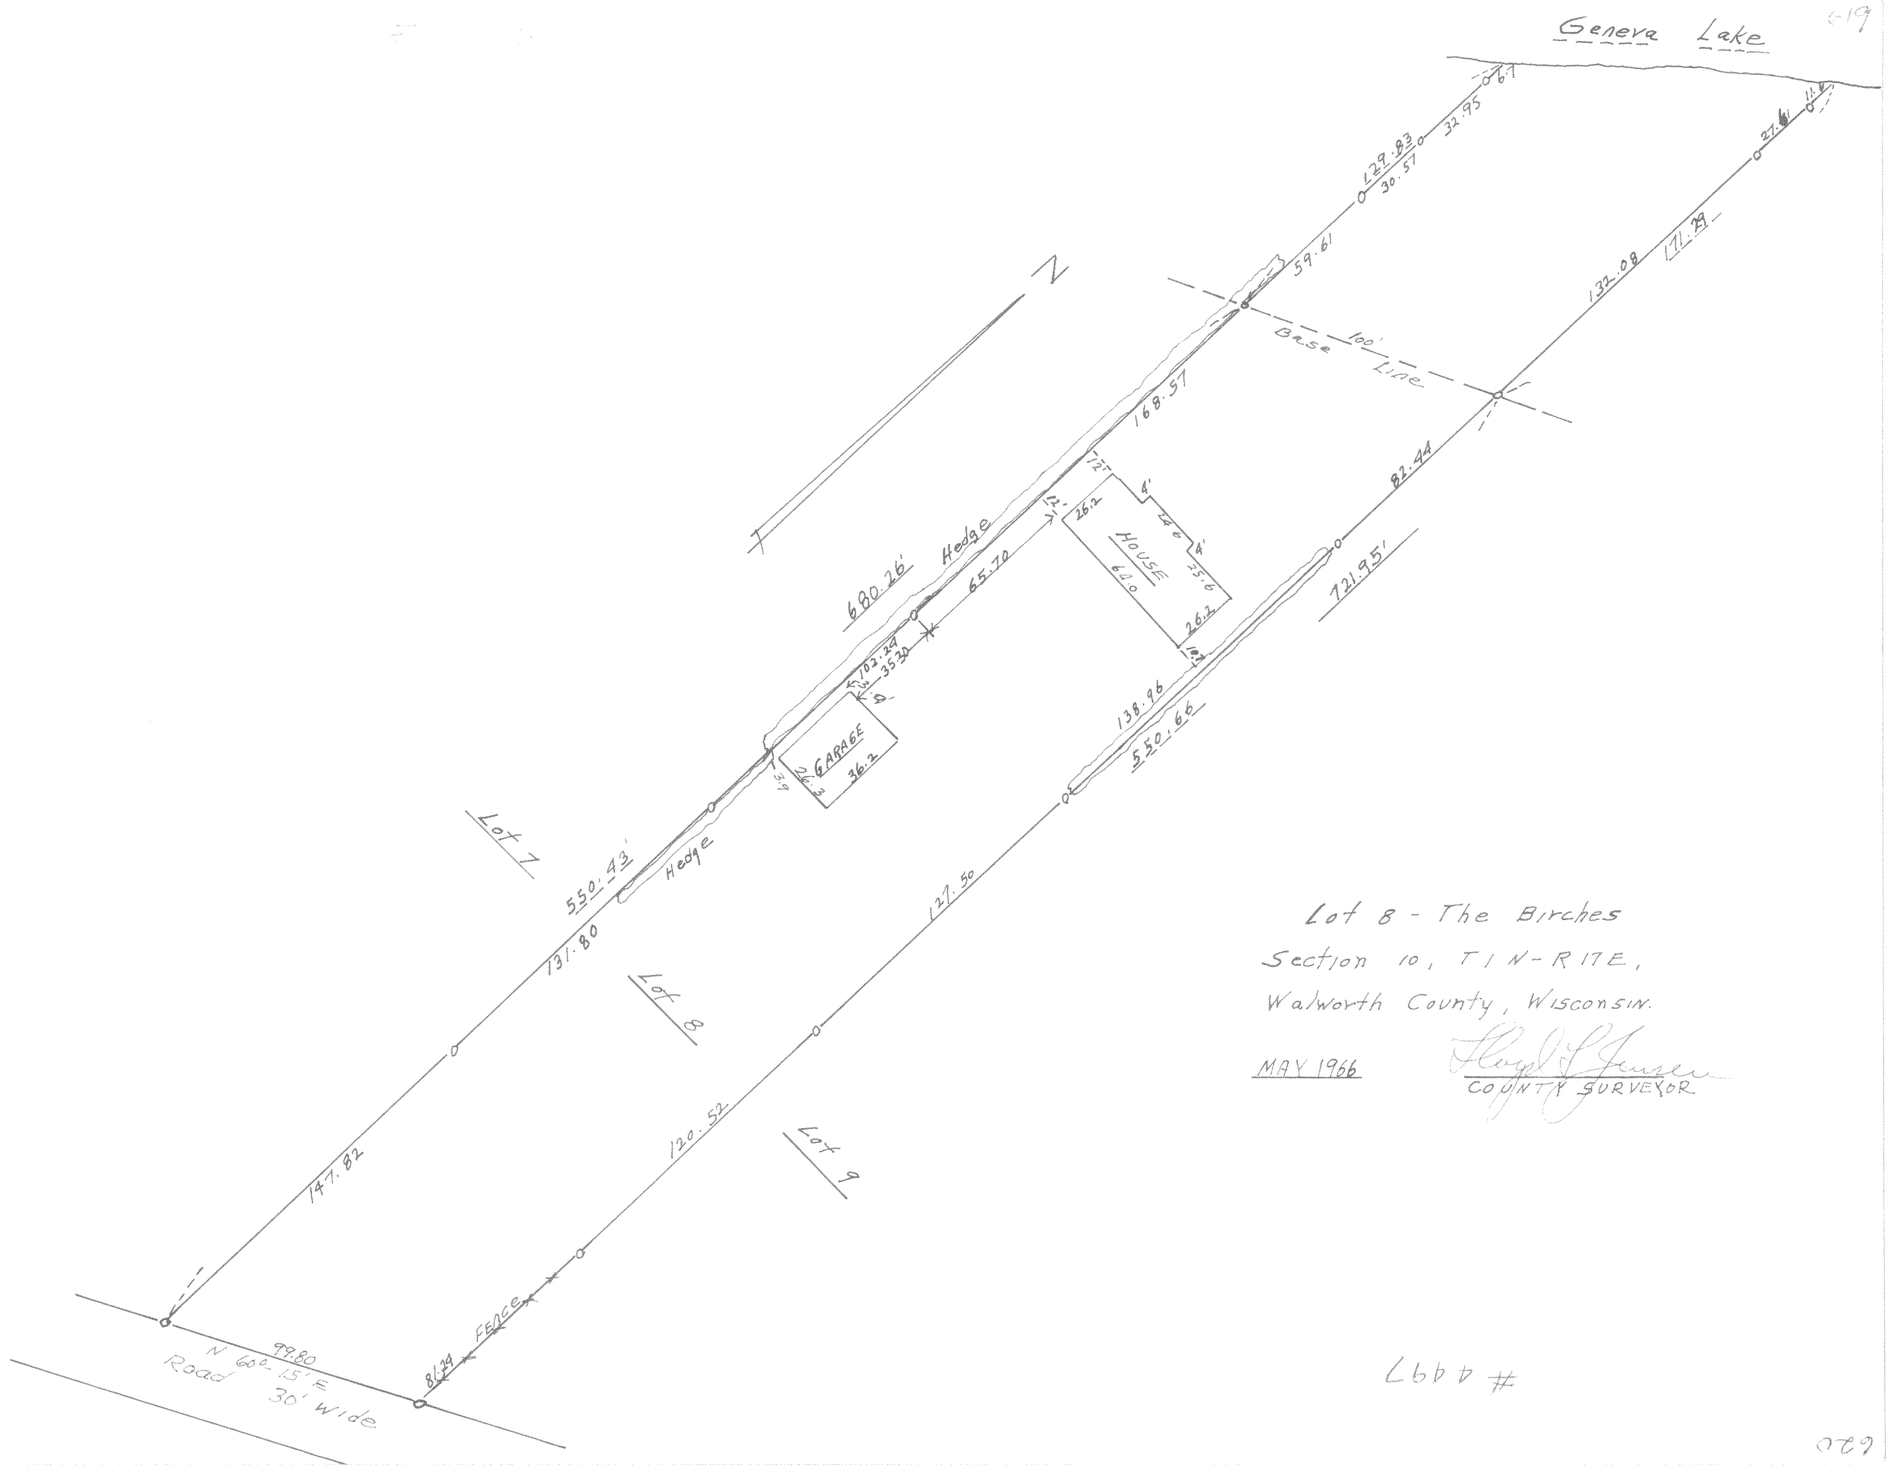

Geneva Lake
N
Base 100' Line
680.26'
Hedge
168.57
65.70
59.61
229.83
30.57
32.95
132.09
171.79
82.44
721.95'
138.96
520.66
127.50
120.52
Lot 7
550.43'
Hedge
131.80
Lot 8
147.82
Lot 9
99.80
N 60°-15' E
Road 30' wide
84.34
FENCE
HOUSE
60.0
GARAGE
36.2
26.2
35.6
4'
7.2'
3.9'
Lot 8 - The Birches
Section 10, T1N-R17E.
Walworth County, Wisconsin.
MAY 1966
Floyd L. Jensen
COUNTY SURVEYOR.
4497