
62-A


#2890

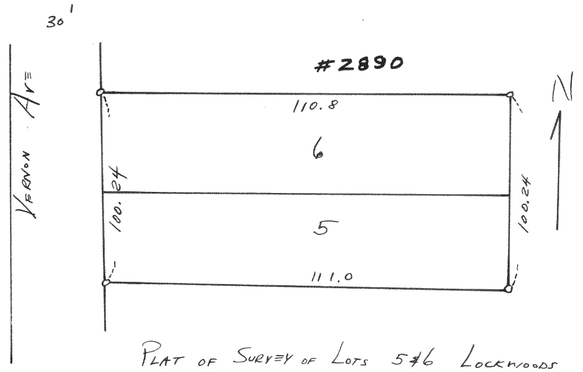

PLAT OF SURVEY OF LOTS 5 & 6 LOCKWOODS SUBD
VILLAGE OF WMS BAY WALWORTH COUNTY, WISC
AUG 1954

Lloyd L Jones
County Surveyor


#2892

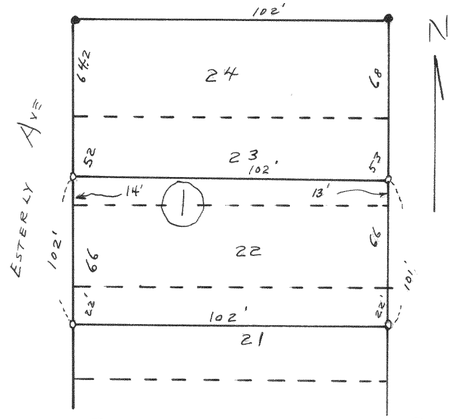

PLAT OF SURVEY OF LOT 22 AND PART OF LOTS 21 AND 23
FISH & JOHNSON ADD'N TO THE CITY OF WHITEWATER
WALWORTH COUNTY, WISCONSIN
MAY 1954

Lloyd L Jones
County Surveyor


#2891

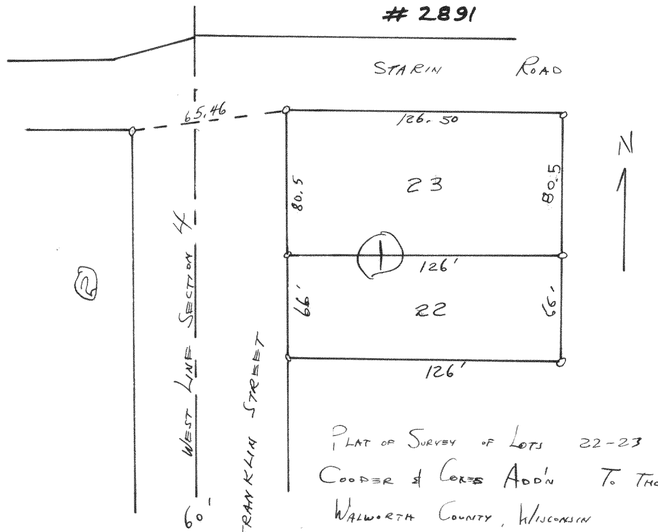

PLAT OF SURVEY OF LOTS 22-23 BLOCK 1
COOPER & CORES ADD'N TO THE CITY OF WHITEWATER
WALWORTH COUNTY, WISCONSIN
DEC 1954

Lloyd L Jones
County Surveyor

#2893

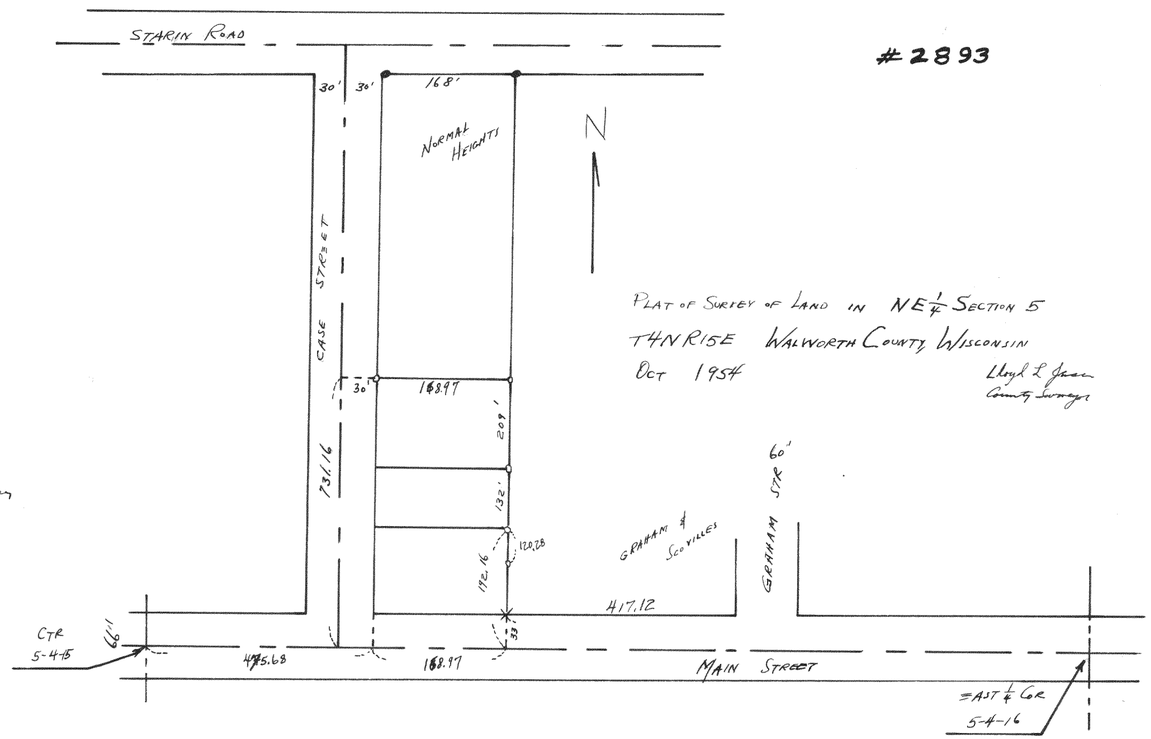

PLAT OF SURVEY OF LAND IN NE¼ SECTION 5
T4N R15E WALWORTH COUNTY WISCONSIN
OCT 1954

Lloyd L Jones
County Surveyor