

#2905

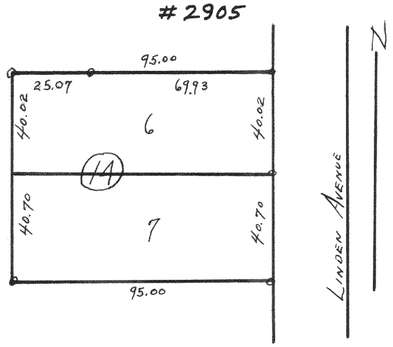

Plat of Survey of Lots 6-7, Block 14
Glenwood Springs Village of Fontana-on-
Geneva Lake, Walworth County, Wisc
Aug 1954


Lloyd L Jones
County Surveyor

#2906

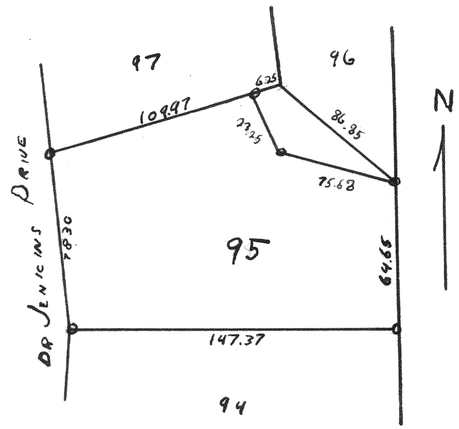


Plat of Survey of Lot 95 Unit II
Country Club Estates Village of Fontana
on Geneva Lake Walworth County Wisconsin
Oct 1954
LLJ
CS

#2907

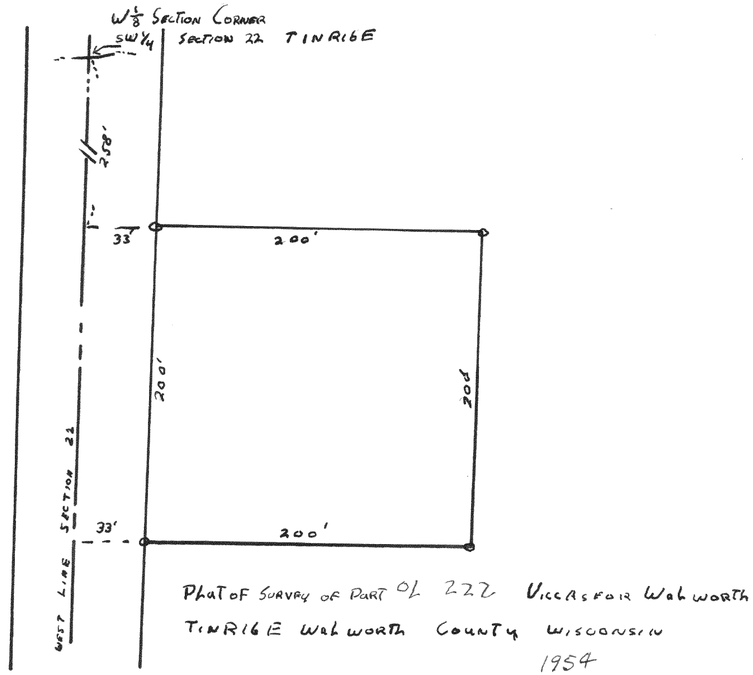


Plat of Survey of Part of 222 Vicinity for Walworth
T1N R16E Walworth County Wisconsin
1954

#2908

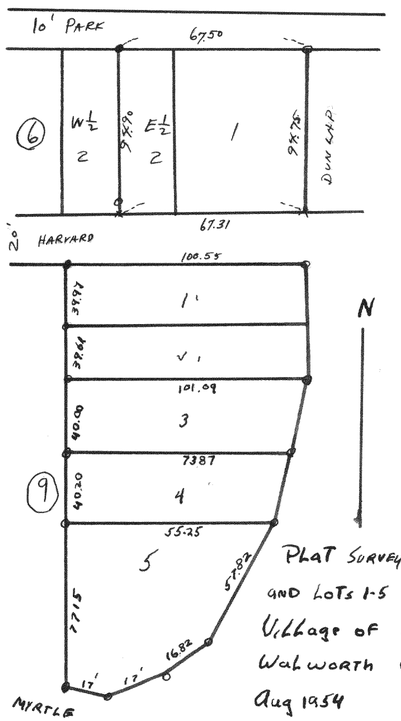

Plat Survey of Lot 1 and E 1/2 of 2 Block 6
and Lots 1-5 Block 9 Glenwood Springs
Village of Fontana Geneva Lake
Walworth County Wisconsin
Aug 1954
LLJ
CS

2909

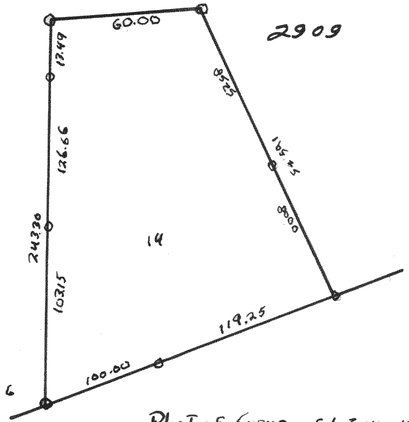

Plat of Survey of Lot 14 Unit #1
Country Club Estates Village of Fontana
on Geneva Lake Walworth County Wisconsin
October 1954
LLJ
CS