
#4524

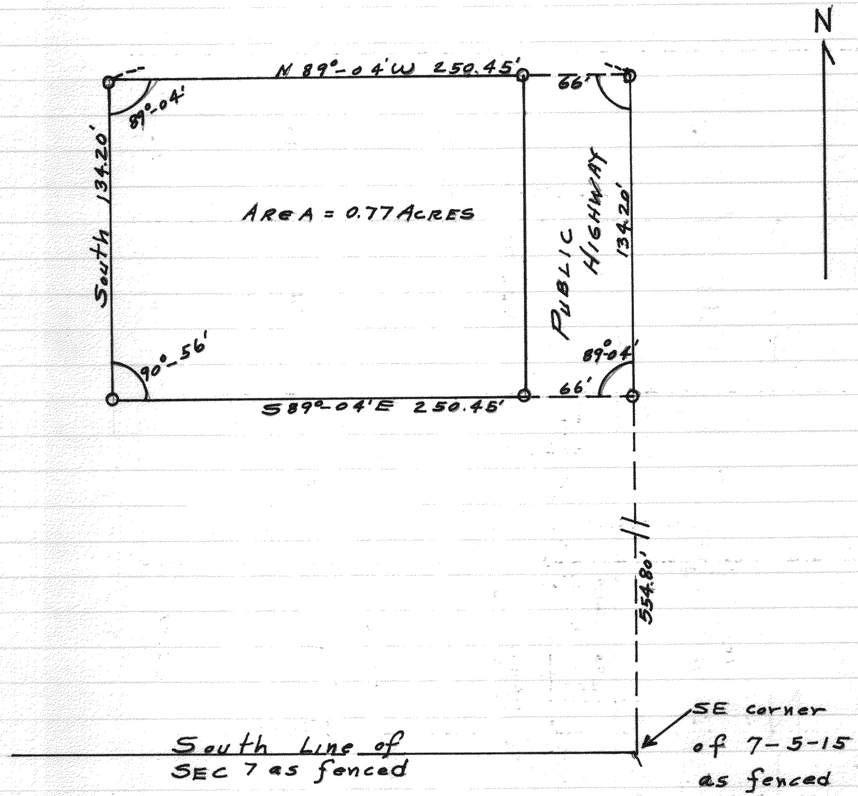

Survey of residence lot located in the SE 1/4 Section 7, T5N R15E of Jefferson County, Wis.

Floyd L Jensen
Surveyor

JULY 1966

#4525


PLAT OF SURVEY

OF

LOT 4 of BLOCK 4 of COOL HILL PARK SUBDIVISION LOCATED IN SECTION 35, T 4 N R 16 E of WALWORTH COUNTY WISCONSIN.

COOL HILL DRIVE

66 FEET WIDE

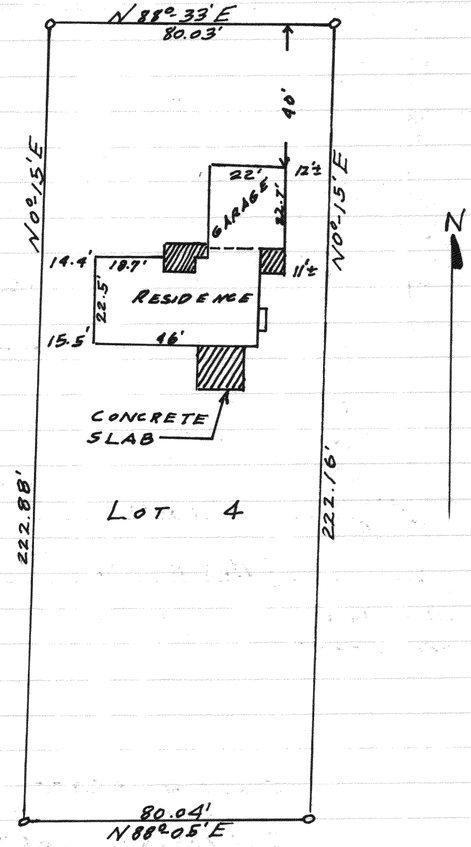

MAY 17, 1967

Floyd L Jensen
SURVEYOR