

#2910

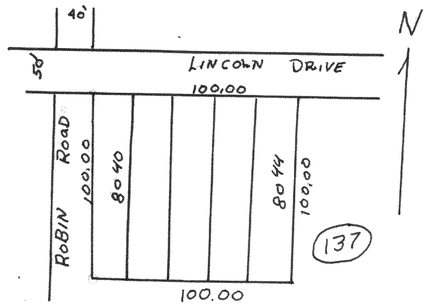


Plat of Survey of Lots 8040-8044 Block 137 Lake Como Beach T2N R17E Walworth County Wisconsin
March 1954 Lloyd L Jensen CS

#2910½

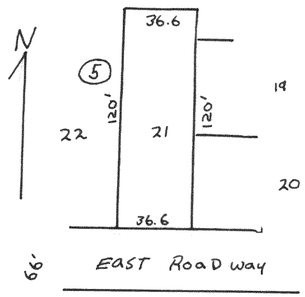


Plat of Survey of Lot 21 Block 5 Sunset Hills T1N R17E Walworth County Wisconsin
July 1954 Lloyd L Jensen CS

#2913

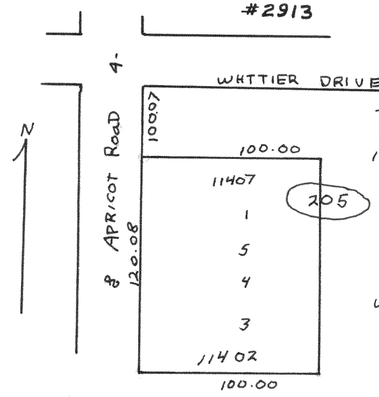


Plat of Survey of Lots 11402-11407 Blk 205 Lake Como Beach T1N R17E Walworth County Wisconsin
July 1954 Lloyd L Jensen CS

#2911

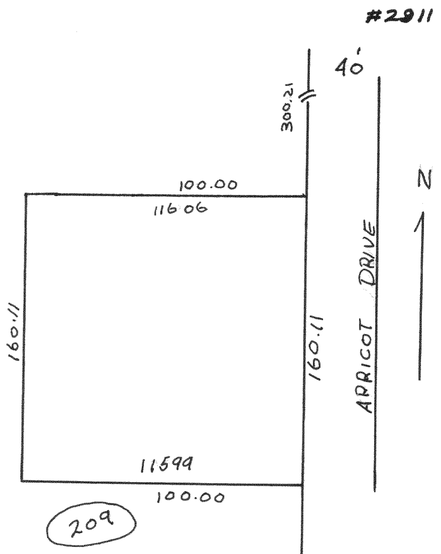


Plat of Survey of Lots 11599-11606 Blk. 209 Lake Como Beach T1N R17E Walworth County Wisconsin
July 1954 Lloyd L Jensen CS

#2914

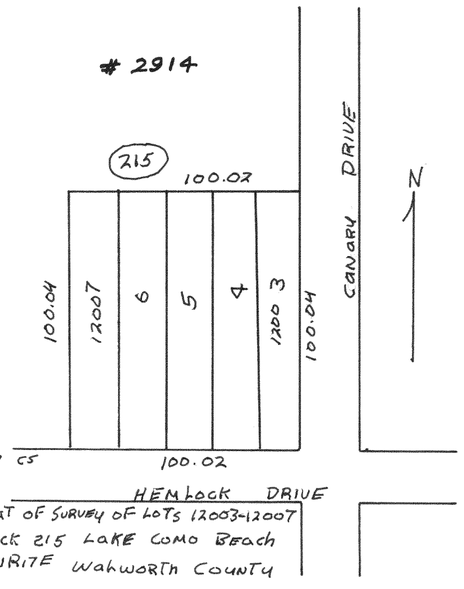

Plat of Survey of Lots 12003-12007 Block 215 Lake Como Beach T2N R17E Walworth County Wisconsin
Aug. 1954 LLJ CS


#2912

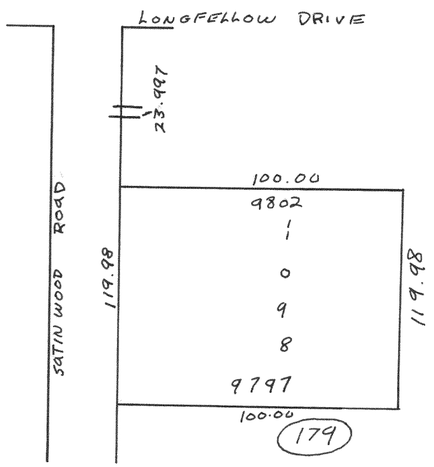



Plat of Survey of Lots 9797 9802 Block 179 Lake Como Beach T2N R17E Walworth County Wisconsin July 1954 LLJ CS

#2915

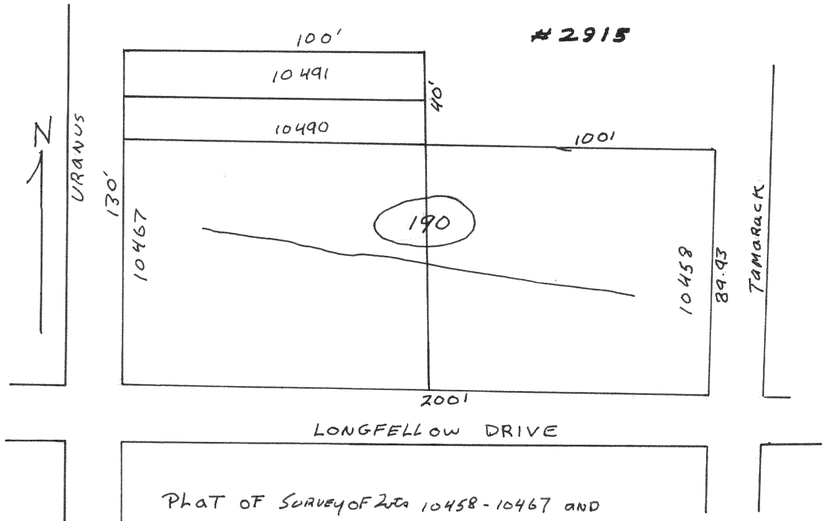

Plat of Survey of Lots 10458-10467 and Lots 10490-10491 Block 190 Lake Como Beach T2N R17E Walworth County Wisconsin
June 1954 LLJ CS