692

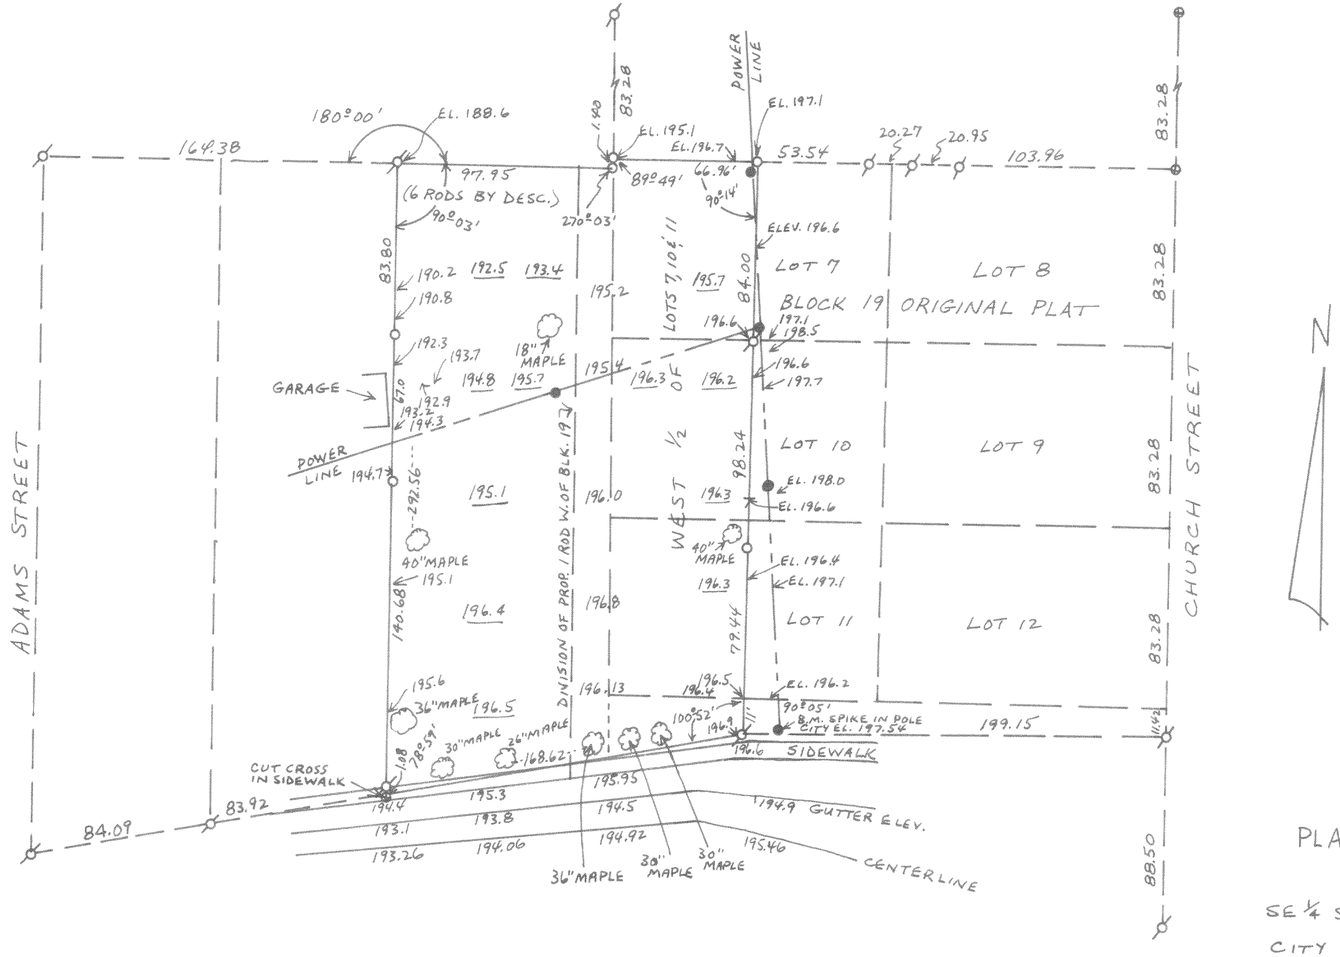

#4592

PLAT OF SURVEY
OF

SE ¼ SEC. 36, T3N R16E
CITY OF ELKHORN
WALWORTH COUNTY, WIS.

JAN. 13, 1969

COUNTY SURVEYOR