
#4575

PLAT OF SURVEY
SEC 9
LOTS 9 + 10 McGRAW'S PARK
TANRIBE WAL. COUNTY, WIS.
JULY 1966

Floyd L Jensen
Lloyd L Jensen
COUNTY SURVEYOR

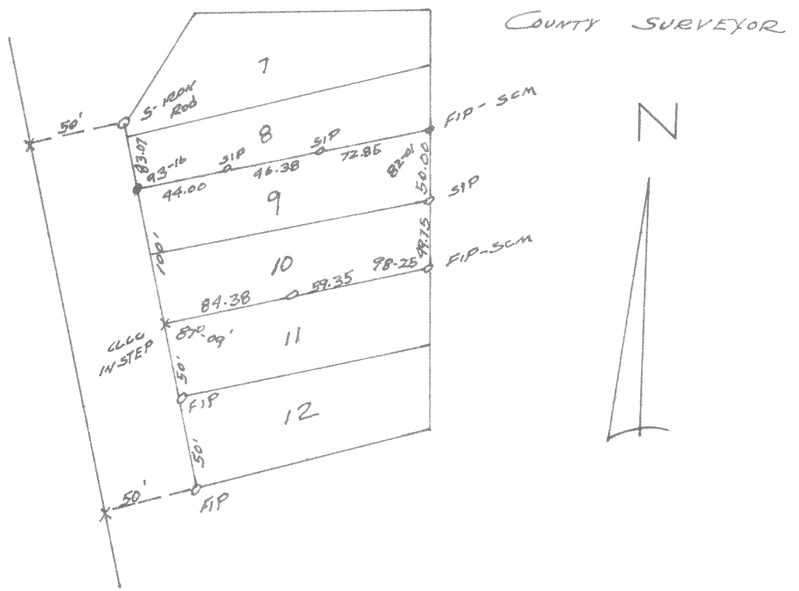

#4576

PLAT OF SURVEY
OF
A PARCEL OF LAND LOCATED IN THE W½ OF SECTION 23, T4N, R18E, WALWORTH COUNTY, WISCONSIN.
JUNE 1968

Floyd L Jensen
COUNTY SURVEYOR

