

#4578

PLAT OF SURVEY
OF
LOT 45 BAYWOOD HEIGHTS ADDITION
NO. 1 - NW 1/4 SECTION 1, T1N-R16E
VILLAGE OF WILLIAMS BAY, WISCONSIN.
APRIL 19, 1968

Floyd F. Jensen
COUNTY SURVEYOR

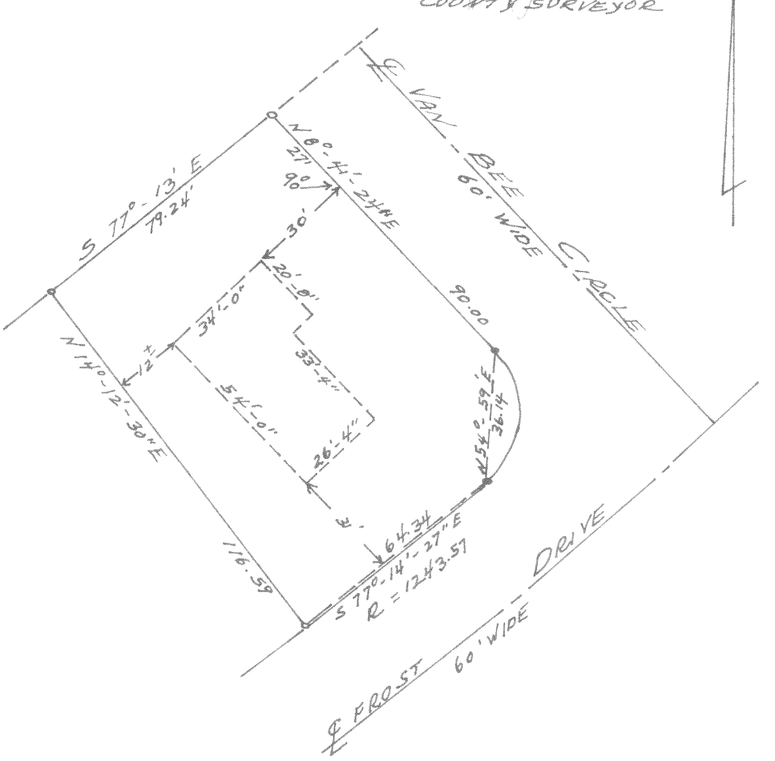

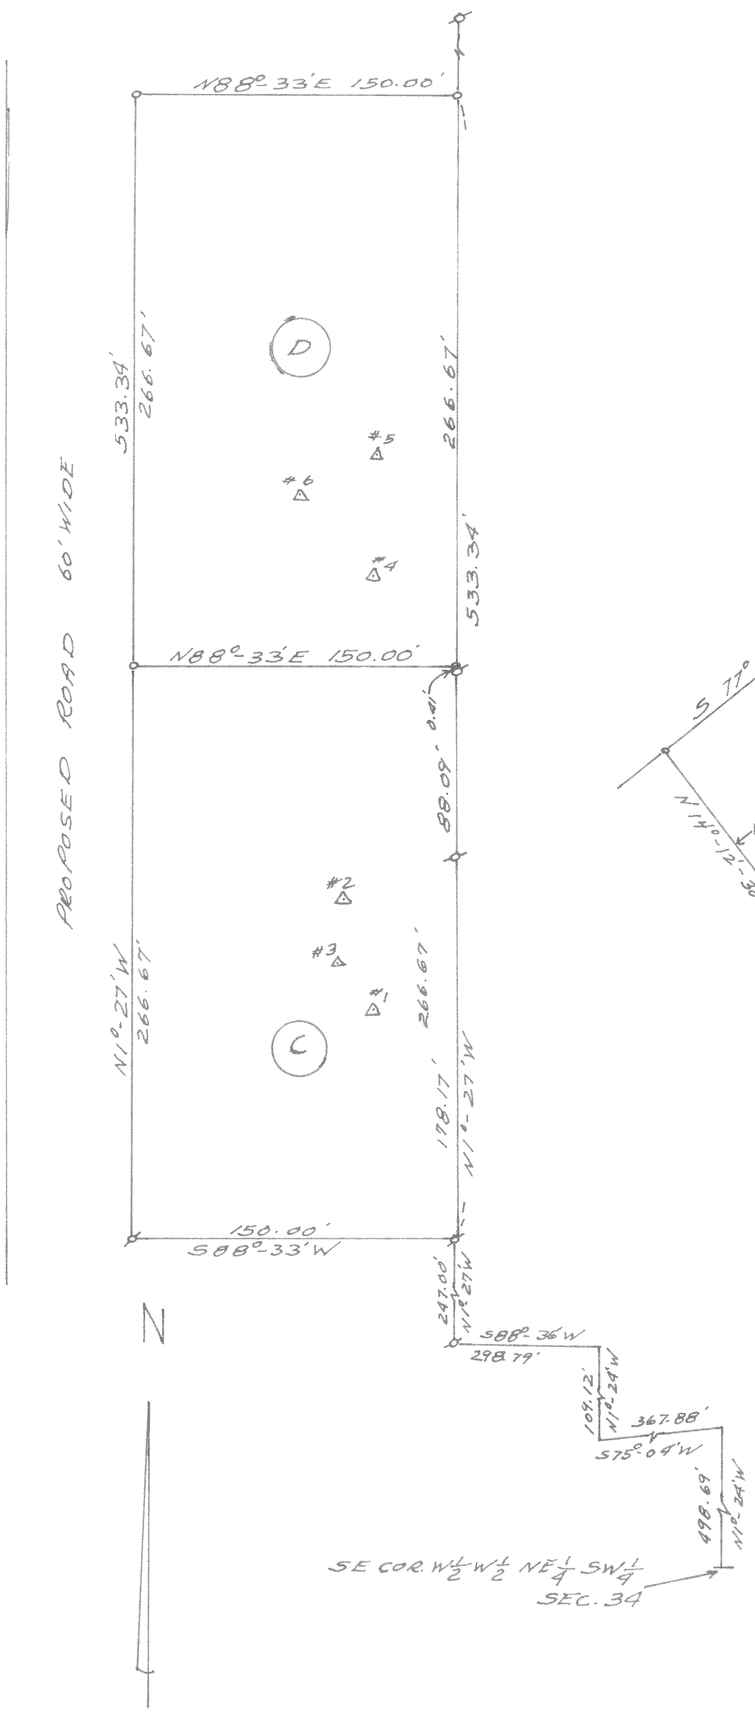

#4579

PLAT OF SURVEY
OF
A PARCEL OF LAND LOCATED
IN THE SW 1/4 OF SECTION 34
T2N R17E WALWORTH COUNTY,
WIS.
JUNE 1968

Floyd F. Jensen
COUNTY SURVEYOR