
2638

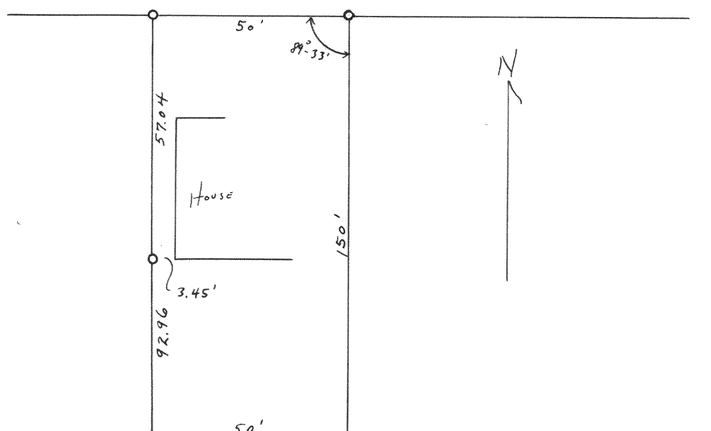


ALLEY

PLAT OF SURVEY OF LOT 38 OF COLUMBIAN SUBDIVISION IN THE CITY OF LAKE GENEVA

July 8, 1952

Lloyd L. Jensen
County Surveyor

2639

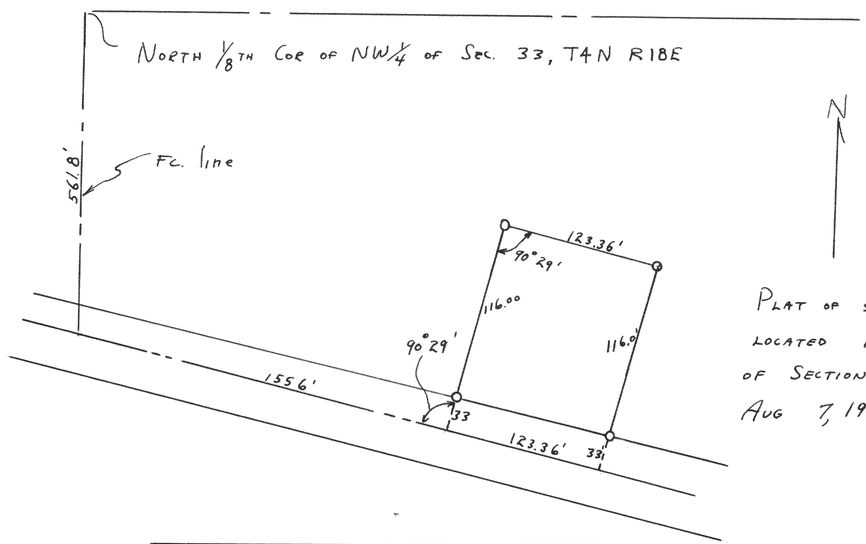


PLAT OF SURVEY OF LAND LOCATED IN THE NORTHWEST 1/4 OF SECTION 33, T4N R18E.

AUG 7, 1952

Lloyd L. Jensen
County Surveyor

2640

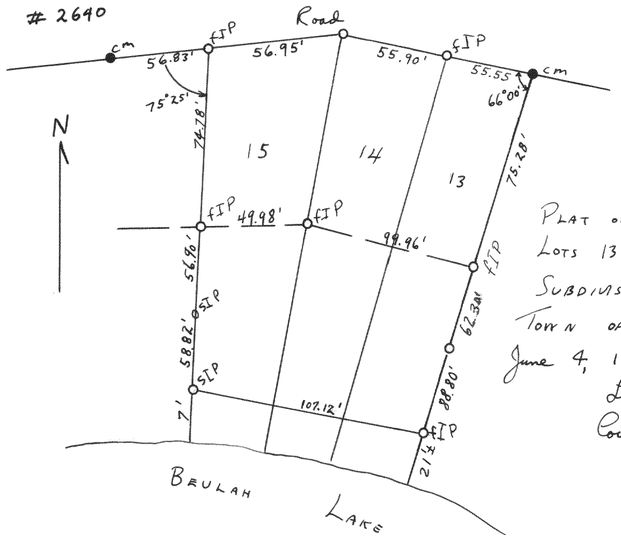


PLAT OF SURVEY OF LOTS 13 & 15 OF FREUCKS' SUBDIVISION IN THE TOWN OF EAST TROY.

June 4, 1952

Lloyd L. Jensen
County Surveyor
CRS.

2641

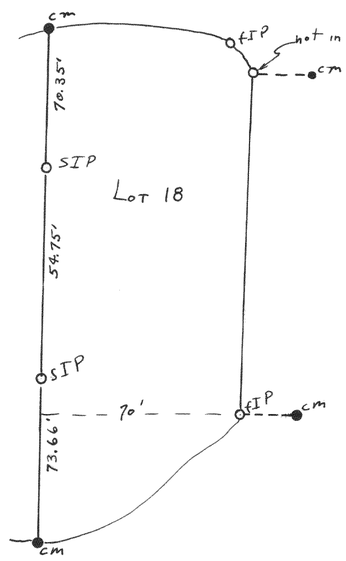

PLAT OF SURVEY OF PART OF LOT 18 OF CLUB UNIQUE IN THE VILLAGE OF FONTANA.

DEC. 1952

Lloyd L. Jensen
County Surveyor