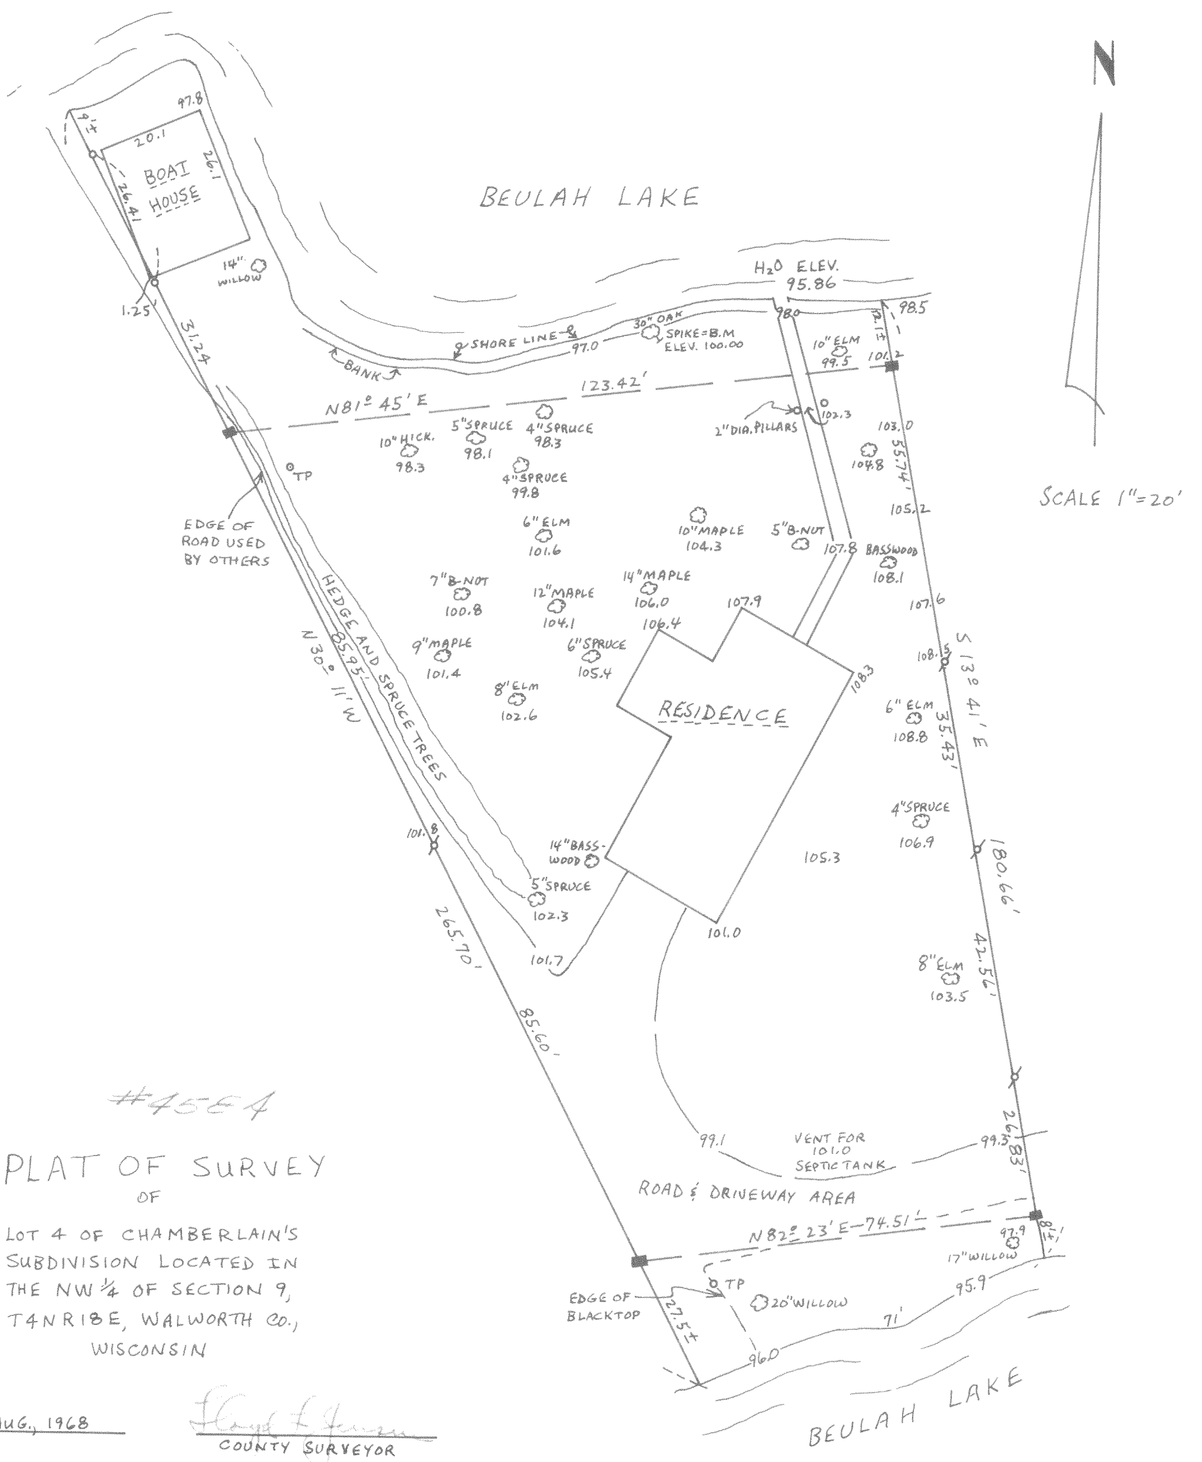


#4564

PLAT OF SURVEY

OF

LOT 4 OF CHAMBERLAIN'S SUBDIVISION LOCATED IN THE NW 1/4 OF SECTION 9, T4NR18E, WALWORTH CO., WISCONSIN

AUG., 1968

COUNTY SURVEYOR