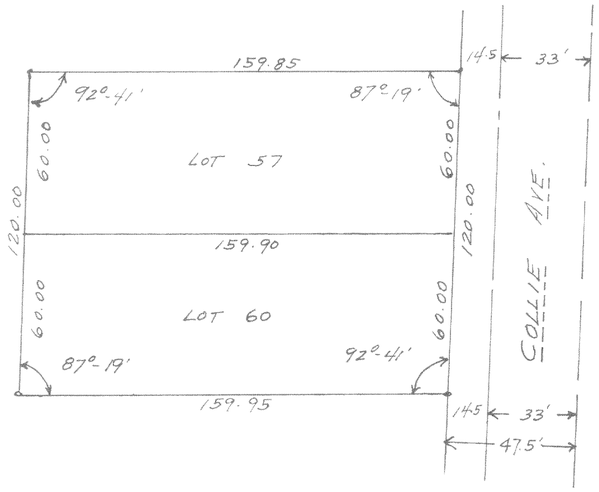


#4587

PLAT OF SURVEY
OF

LOTS 57 AND 60 BAY VIEW SUBDIVISION, VILLAGE OF WILLIAMS BAY, WALWORTH COUNTY, WISCONSIN.

NOV. 15, 1968

Floyd L. Jones
COUNTY SURVEYOR

PLAT OF SURVEY
OF

#4566

LOT 11 AND LOT 12 EXCEPT THE EAST 28.0' S.B. CHAPINS SUBDIVISION SECTION 4, T1N-R17E WALWORTH COUNTY, WISCONSIN

OCT. 1968

Floyd L. Jones
COUNTY SURVEYOR

