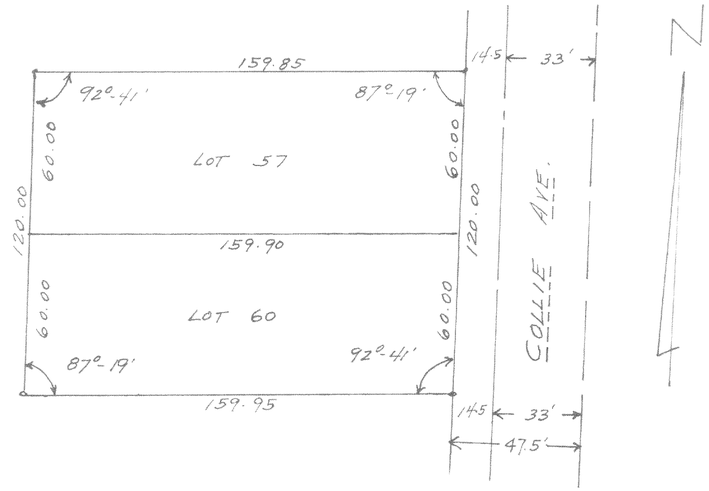

#4587

PLAT OF SURVEY
OF

LOTS 57 AND 60 BAY VIEW SUBDIVISION, VILLAGE OF WILLIAMS BAY, WALWORTH COUNTY, WISCONSIN.

NOV. 15, 1968

COUNTY SURVEYOR

PLAT OF SURVEY
OF

#4588

LOT 11 AND LOT 12 EXCEPT THE EAST 28.0'
S.B. CHAPIN'S SUBDIVISION SECTION 4, T1N-R17E
WALWORTH COUNTY, WISCONSIN

OCT. 1968
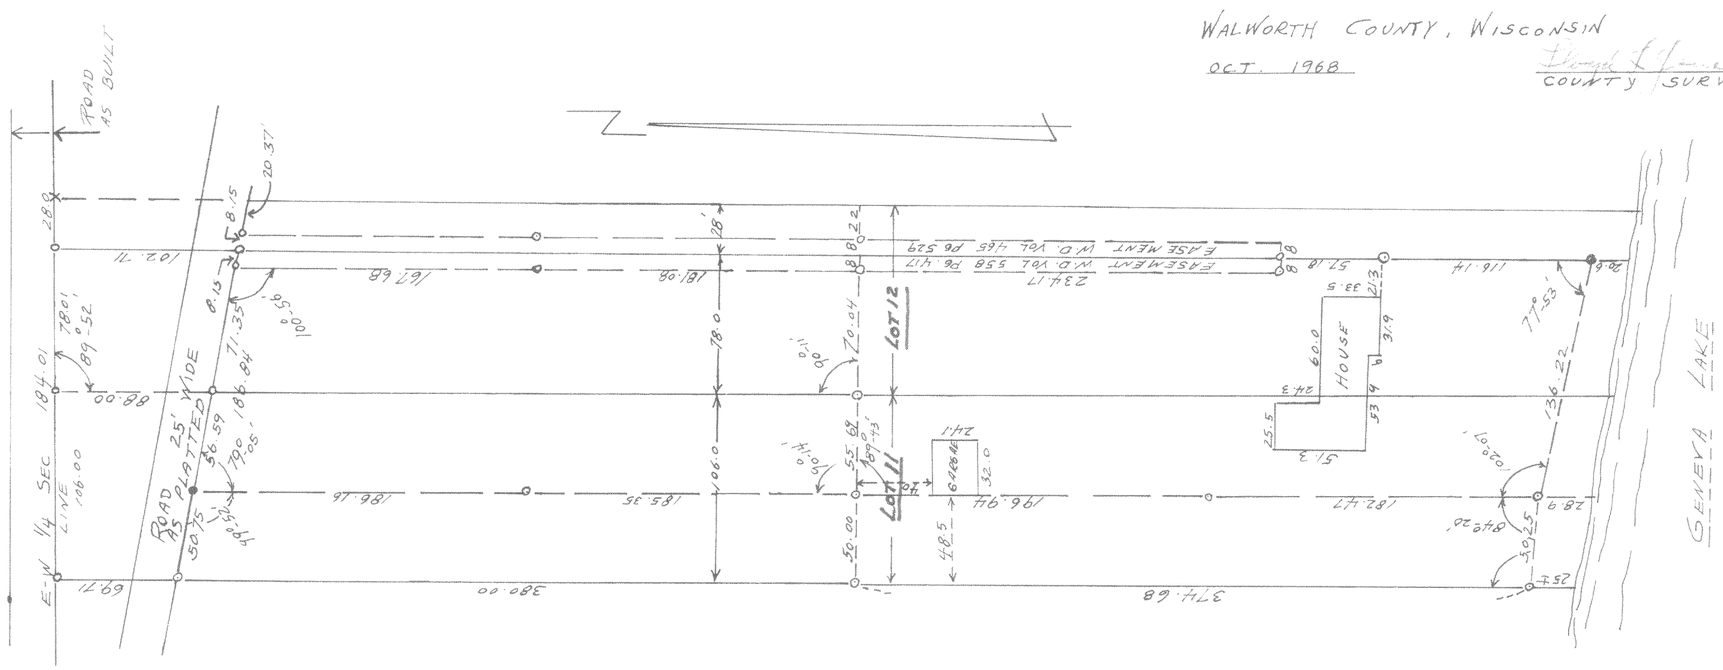
COUNTY SURVEYOR