
#4590

PLAT OF SURVEY

OF

THE WEST 92.00' OF LOTS 1-2-3 BLOCK 1
HARBOR VIEW SUBDIVISION
WILLIAMS BAY, WISCONSIN.

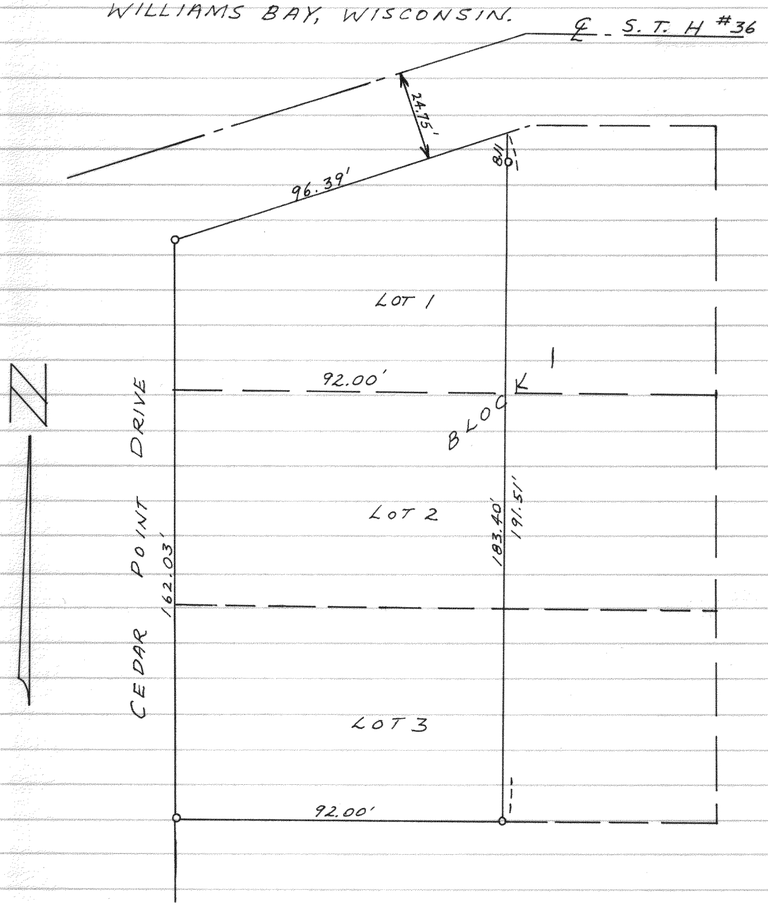

LEGEND
o — Iron Pipe
• — Concrete Monument
Scale 1" = 30'

Date DEC. 1968


Floyd L Jensen
COUNTY SURVEYOR

#4591

PLAT OF SURVEY

OF

PART OF WILLIAMS PARK
W½ SECTION 4, T4NR18E

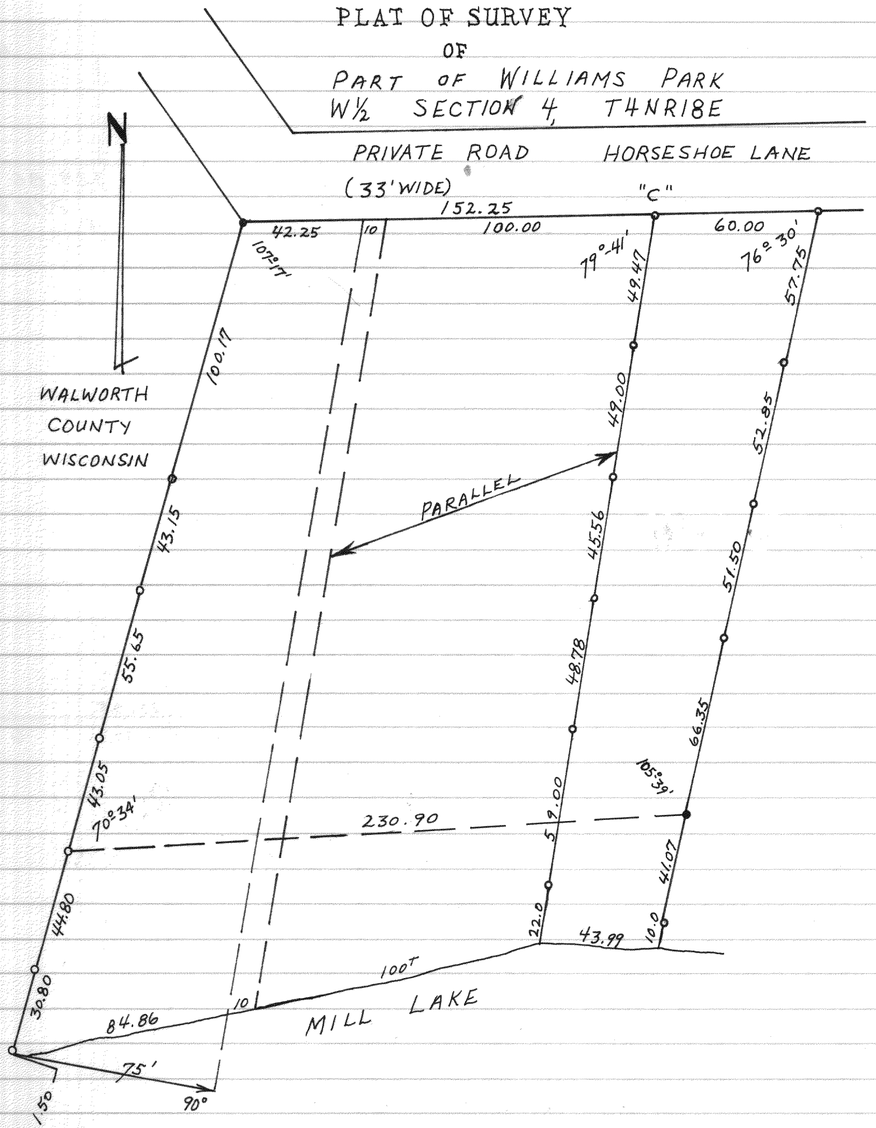

LEGEND
o — Iron Pipe
• — Concrete Monument
Scale 1" = 40'
• - IRON PIPE SET

Date DEC. 1968

Floyd L Jensen
COUNTY SURVEYOR