
#2933

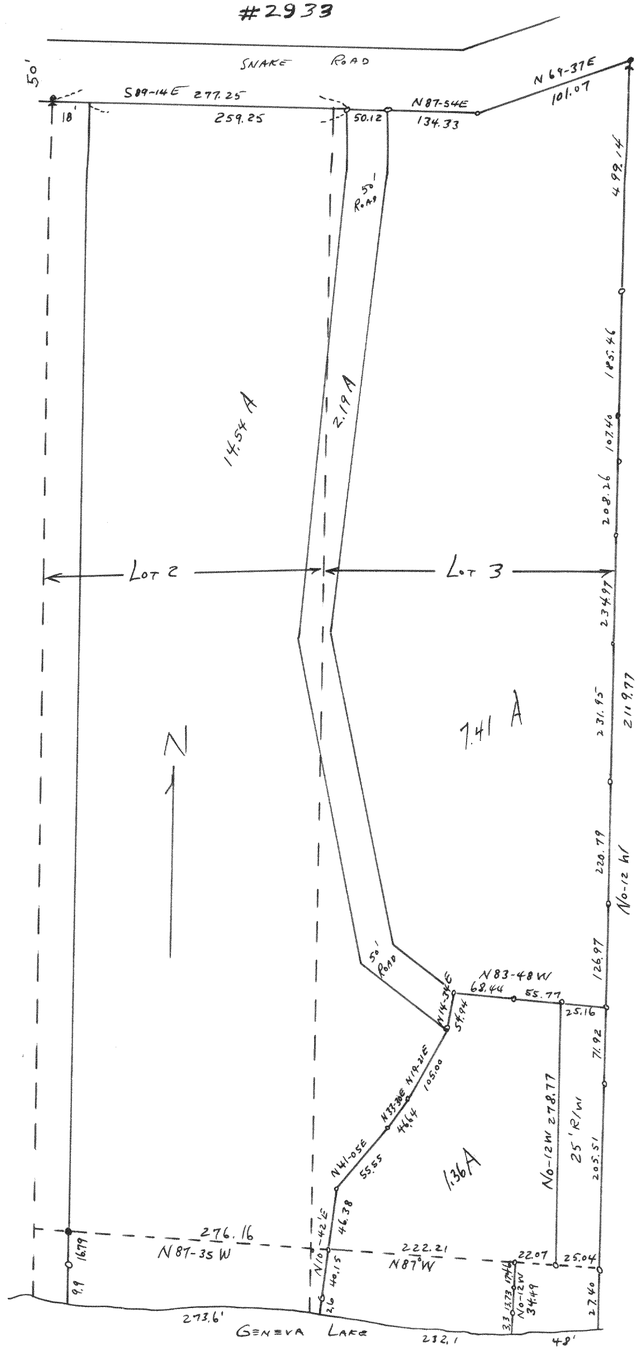


PLAT OF SURVEY OF LOTS 2-3 OF MALLORY SPRINGS SUBD IN GOVT LOT 3 & SECT 3 TIN R17E, WALWORTH COUNTY, WISCONSIN

SEPTEMBER 1954

Lloyd L Jones
County Surveyor

#2934

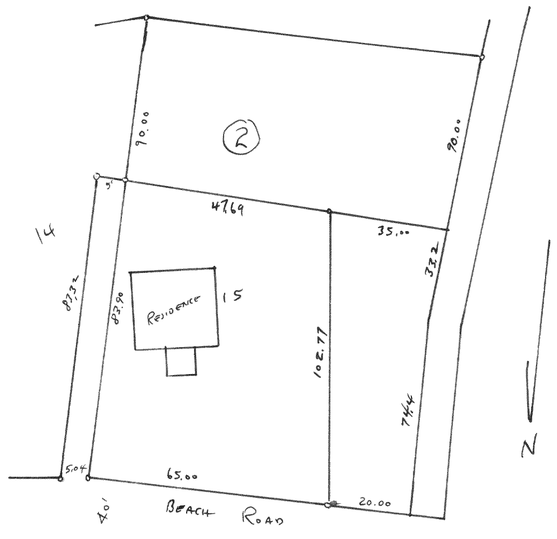


PLAT OF SURVEY OF PART OF LOTS 14-15 BLOCK 2 OF WOODDALE LOCATED IN TIN R17E WALWORTH COUNTY WISCONSIN

AUGUST 1954

Lloyd L Jones
County Surveyor

#2935

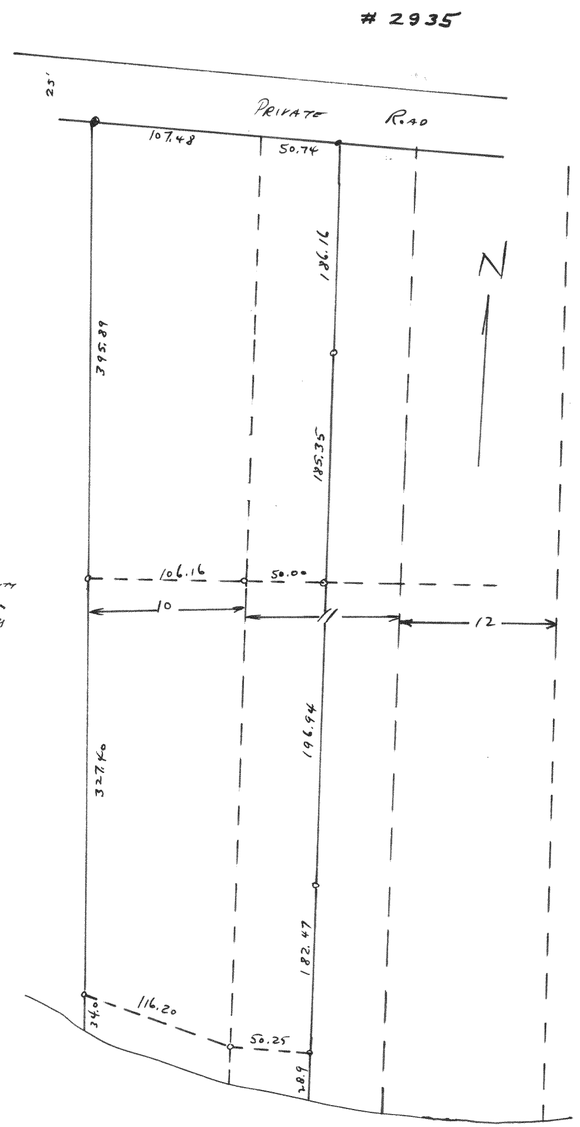


PLAT OF SURVEY OF LOT 10 AND WEST 50' OF LOT 11 & S.B. CHAPIN SUBD IN FR SEC 4, TIN R17E WALWORTH COUNTY, WISCONSIN

MAY 1954

Lloyd L Jones
County Surveyor

#2936

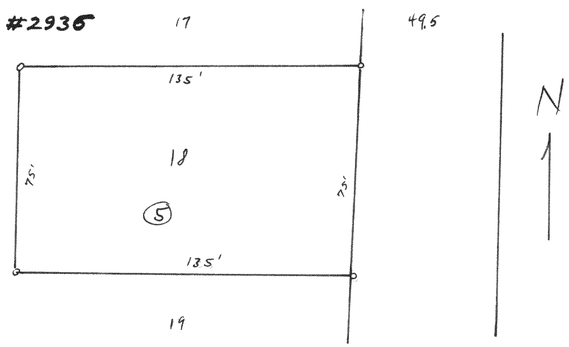

PLAT OF SURVEY OF LOT 18 BLOCK 5 SUNSET HILLS IN SEC 4 TIN R17E WALWORTH COUNTY WIS

MAY 1954

Lloyd L Jones
County Surveyor