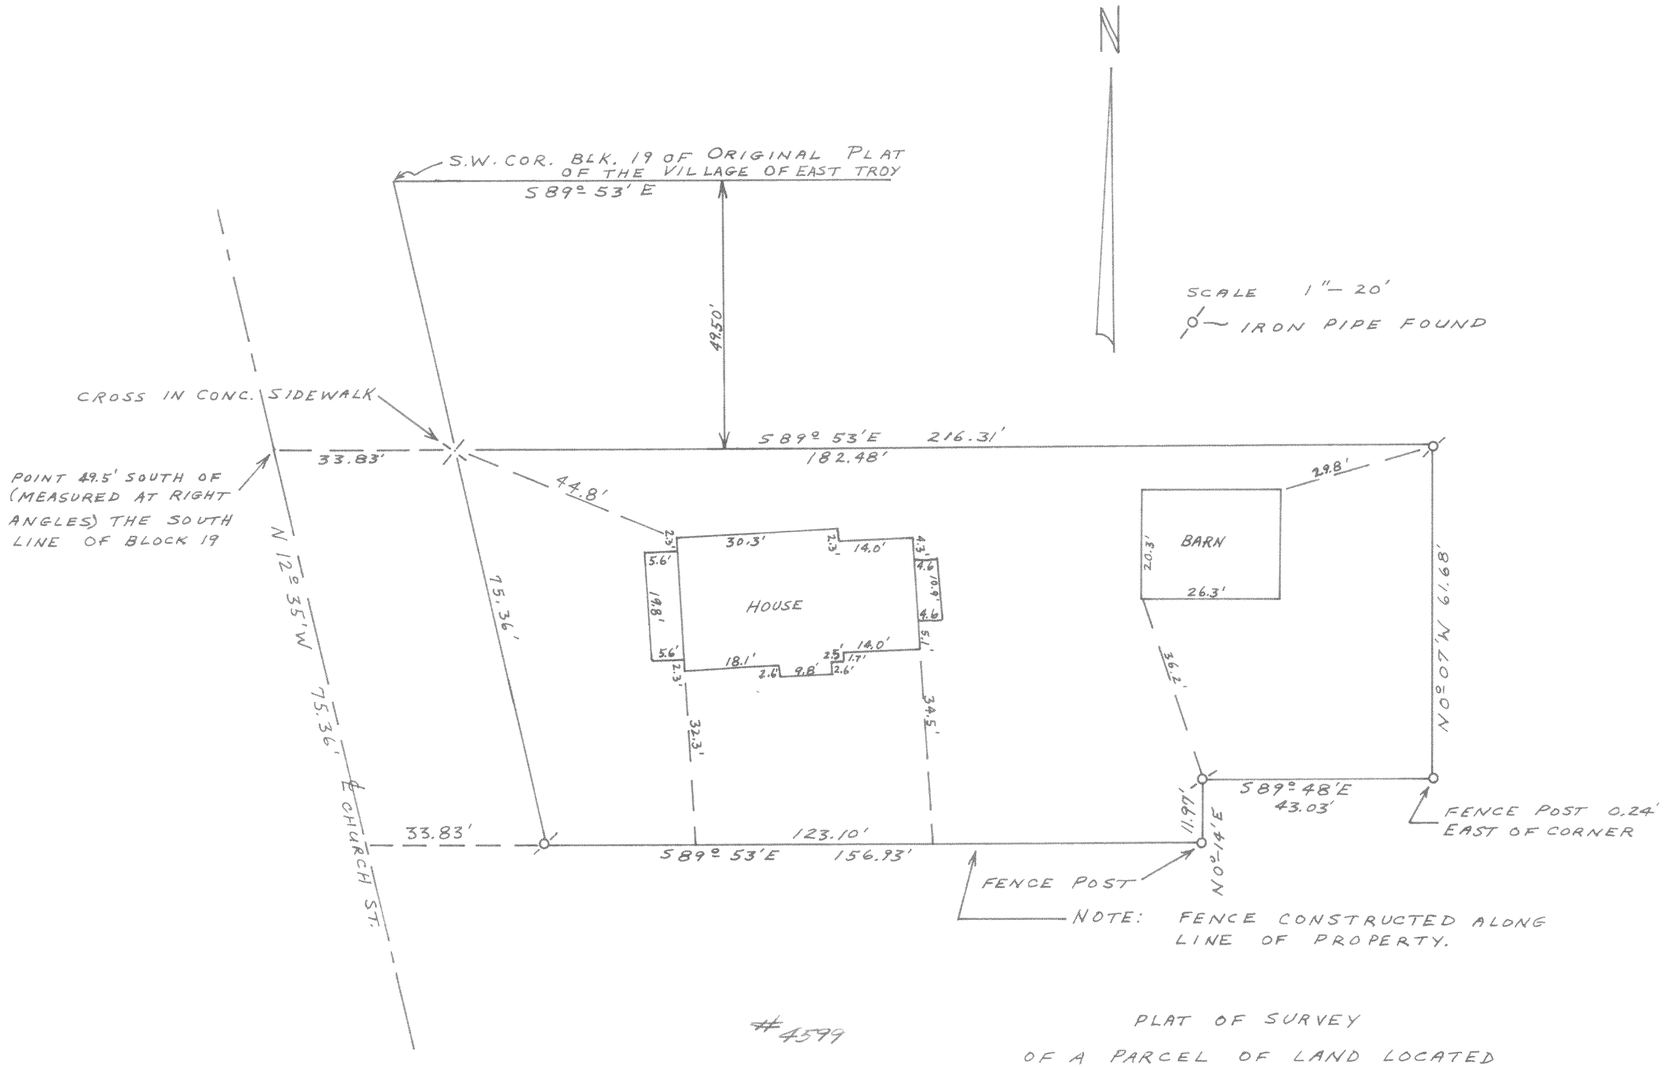


#4599

PLAT OF SURVEY
OF A PARCEL OF LAND LOCATED
IN THE NW ¼ OF SECTION 29,
T 4 N R 18 E WAL. CO. WIS.

OCT. 8, 1968

Floyd F. Jones
COUNTY SURVEYOR