
72


#2937

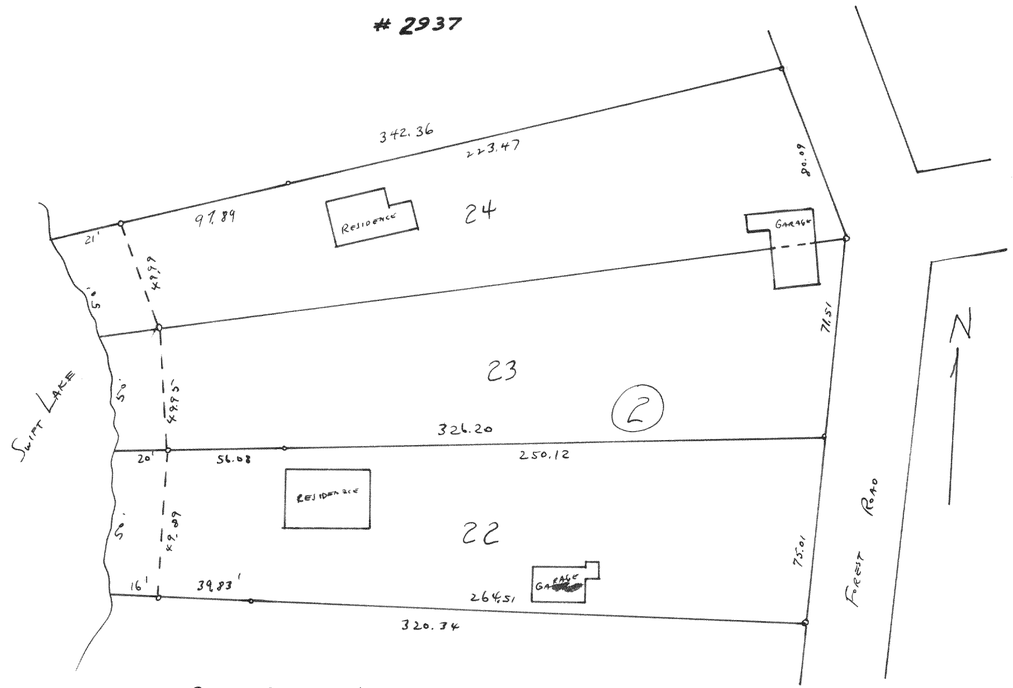

PLAT OF SURVEY OF LOTS 22-23-24 BLOCK 2
SWIFT LAKE SUBD. SEC 8 T4NR17E
WALWORTH COUNTY, WISCONSIN
MARCH 54

Lloyd L Jones
County Surveyor


#2939

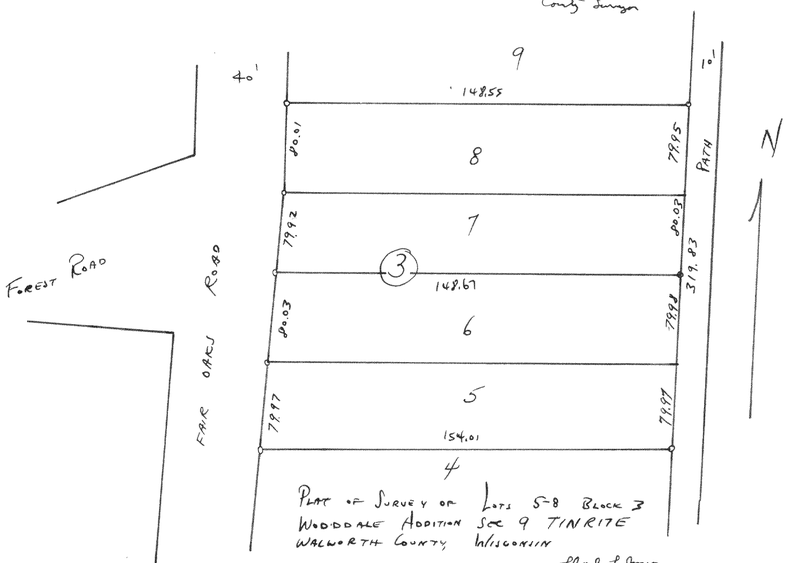

PLAT OF SURVEY OF LOTS 5-8 BLOCK 3
WOODDALE ADDITION SEC 9 T1NR17E
WALWORTH COUNTY, WISCONSIN
MARCH 1954

Lloyd L Jones
County Surveyor

#2938

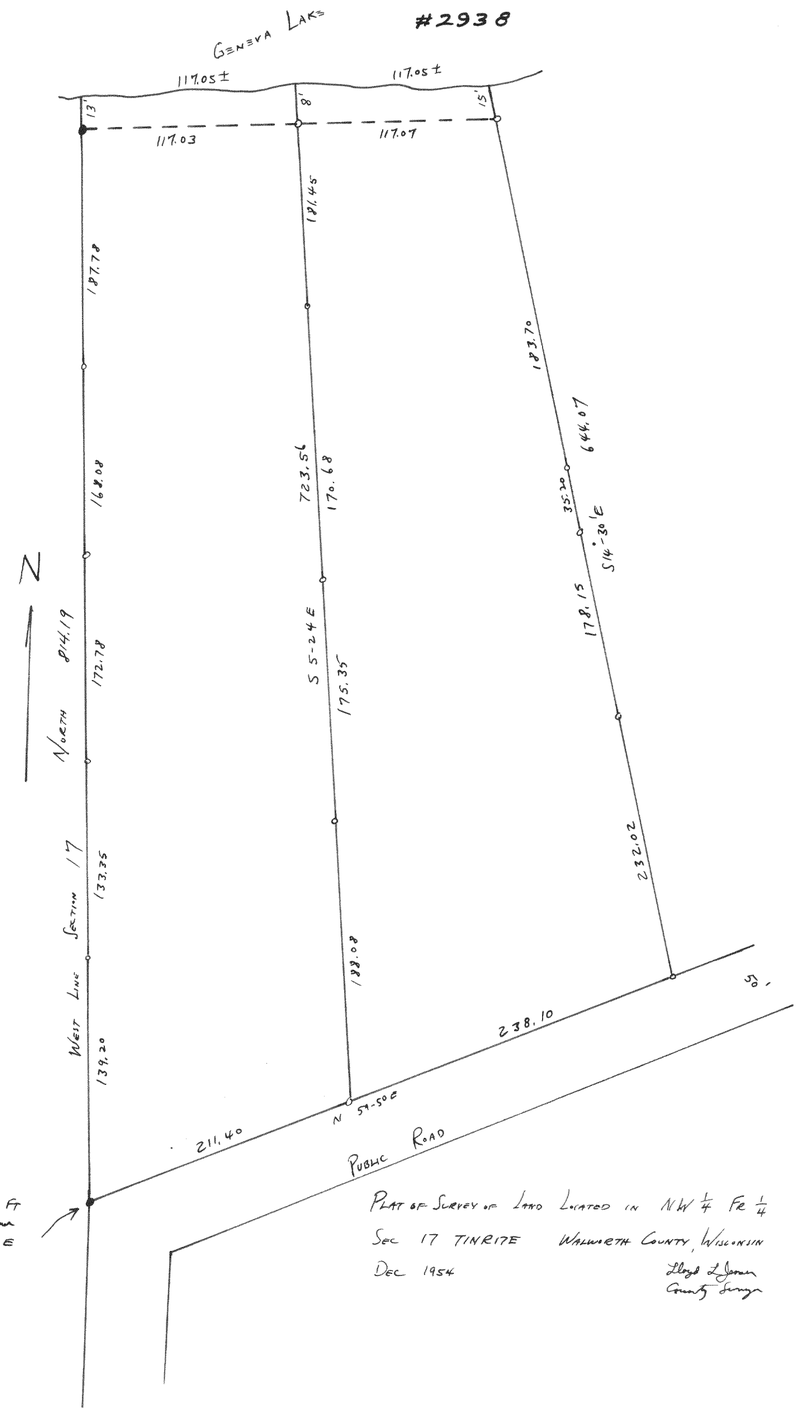

POINT IS 925.12 FT NORTH OF W¼ SEC CORNER SEC 17 T1N R17E

PLAT OF SURVEY OF LAND LOCATED IN NW ¼ FR ¼
SEC 17 T1NR17E WALWORTH COUNTY, WISCONSIN
DEC 1954

Lloyd L Jones
County Surveyor