
722

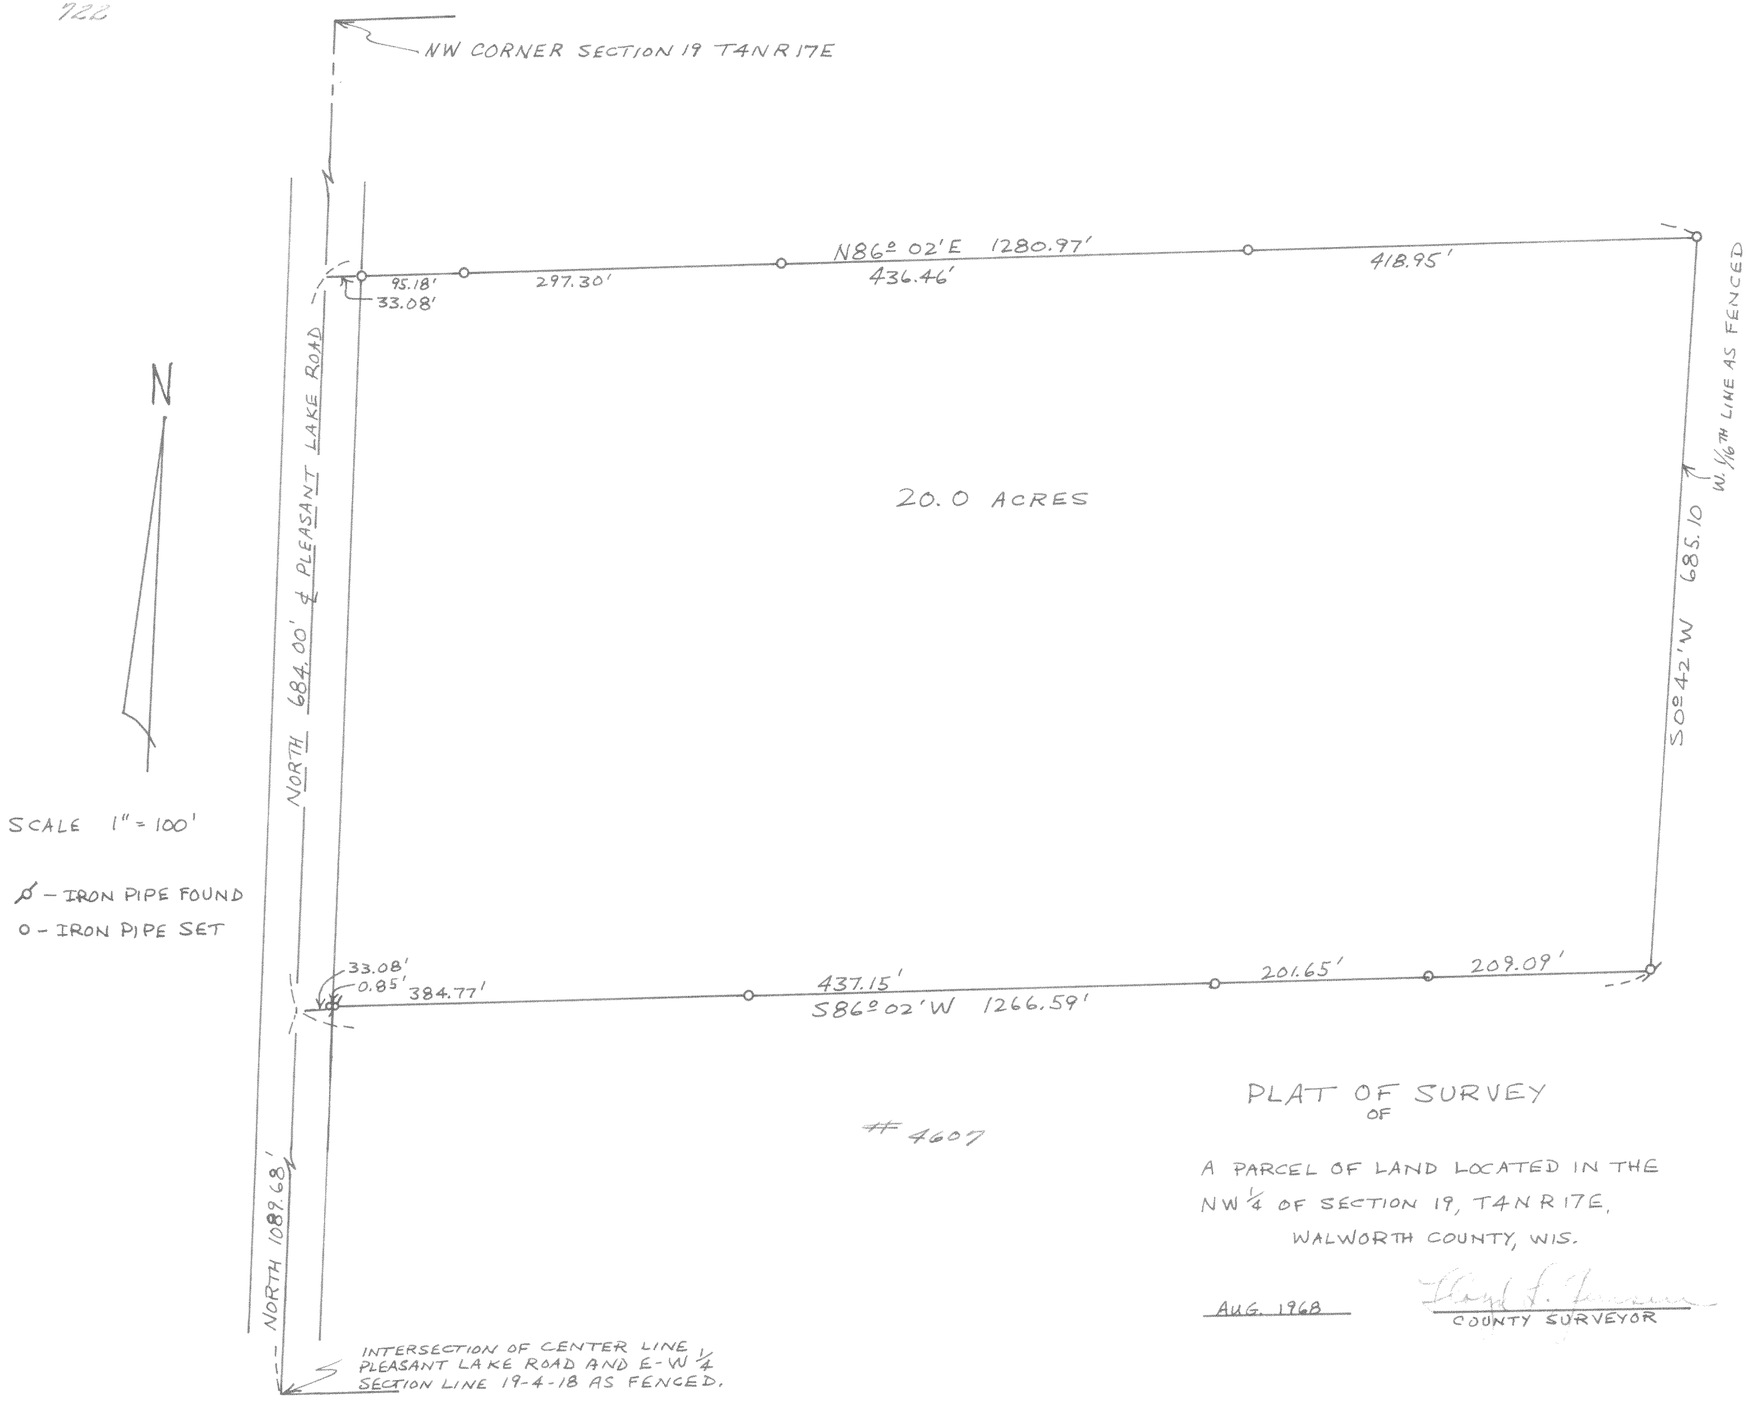

#4607

PLAT OF SURVEY
OF

A PARCEL OF LAND LOCATED IN THE NW 1/4 OF SECTION 19, T4N R17E, WALWORTH COUNTY, WIS.

AUG. 1968

Floyd F. Timmons
COUNTY SURVEYOR