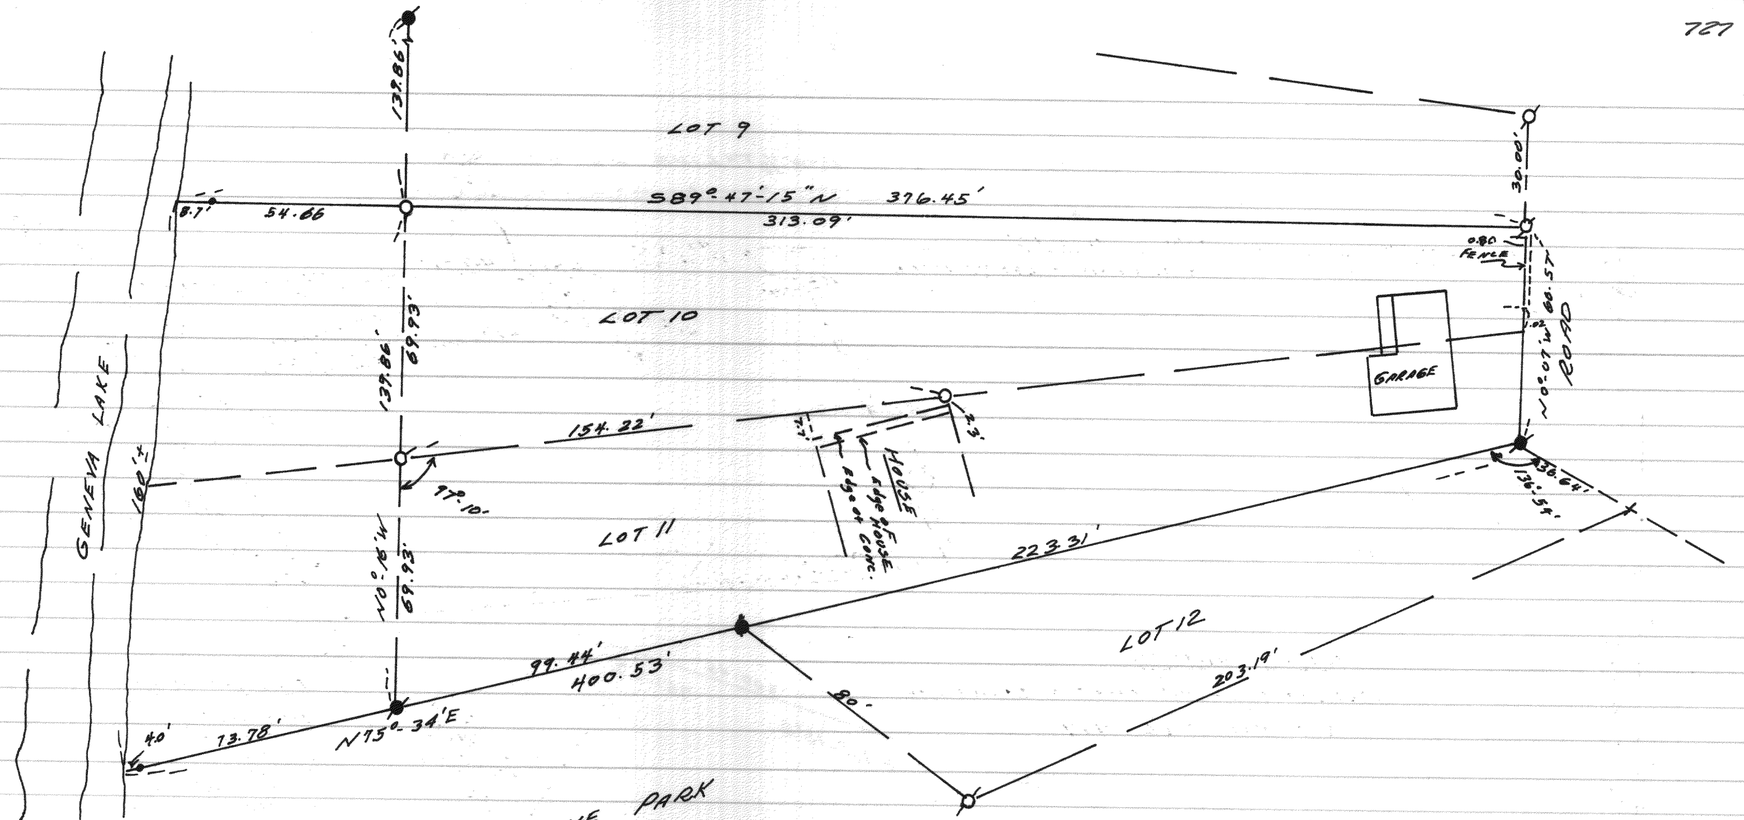

#4611

PLAT OF SURVEY

OF

LOTS 10 & 11 OF FIRST ADDITION CEDAR POINT PARK, VILLAGE OF WILLIAMS BAY, WISCONSIN.

MARCH 1969

Floyd L. Jensen
COUNTY SURVEYOR