#4619


PLAT OF SURVEY

OF

LOT 15 BLOCK 2 MORAINE HEIGHTS SUBD.
LOCATED IN SECTIONS 26 & 35 T4N R15E
WALWORTH COUNTY, WISCONSIN.

MAY 1969

Floyd L Jones
COUNTY SURVEYOR

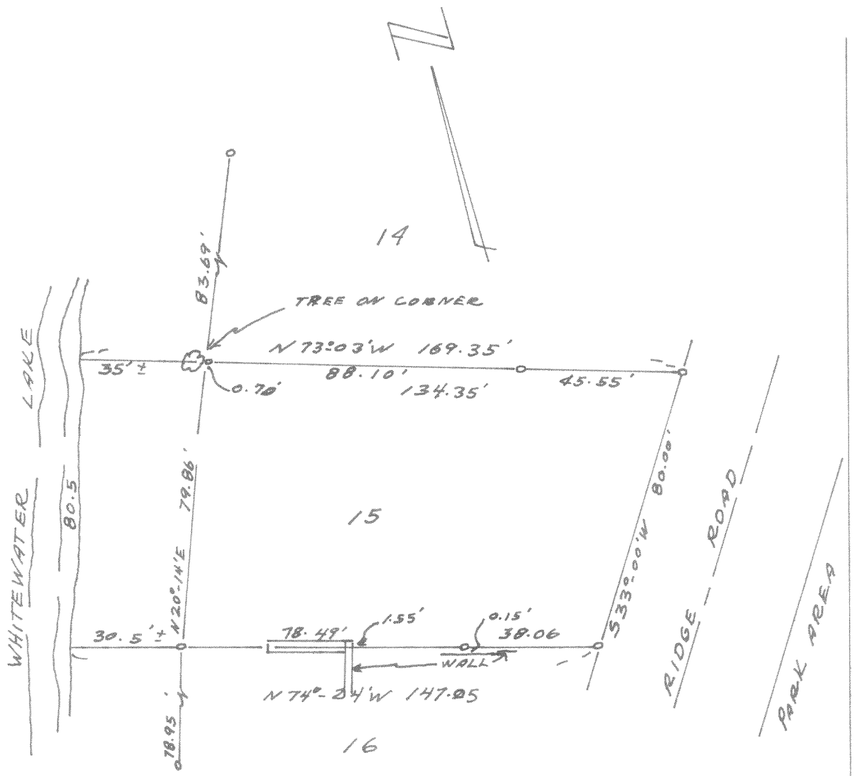

#4620

PLAT OF SURVEY

OF

WALWORTH COUNTY WISCONSIN

THE NORTH 190' OF THE EAST 61.50'
LOT 5 - OBSERVATORY SUBDIVISION
SW1/4 SECTION 1, T1N-R16E, WILLIAMS BAY

MAY 23, 1969

Floyd L Jones
SURVEYOR

