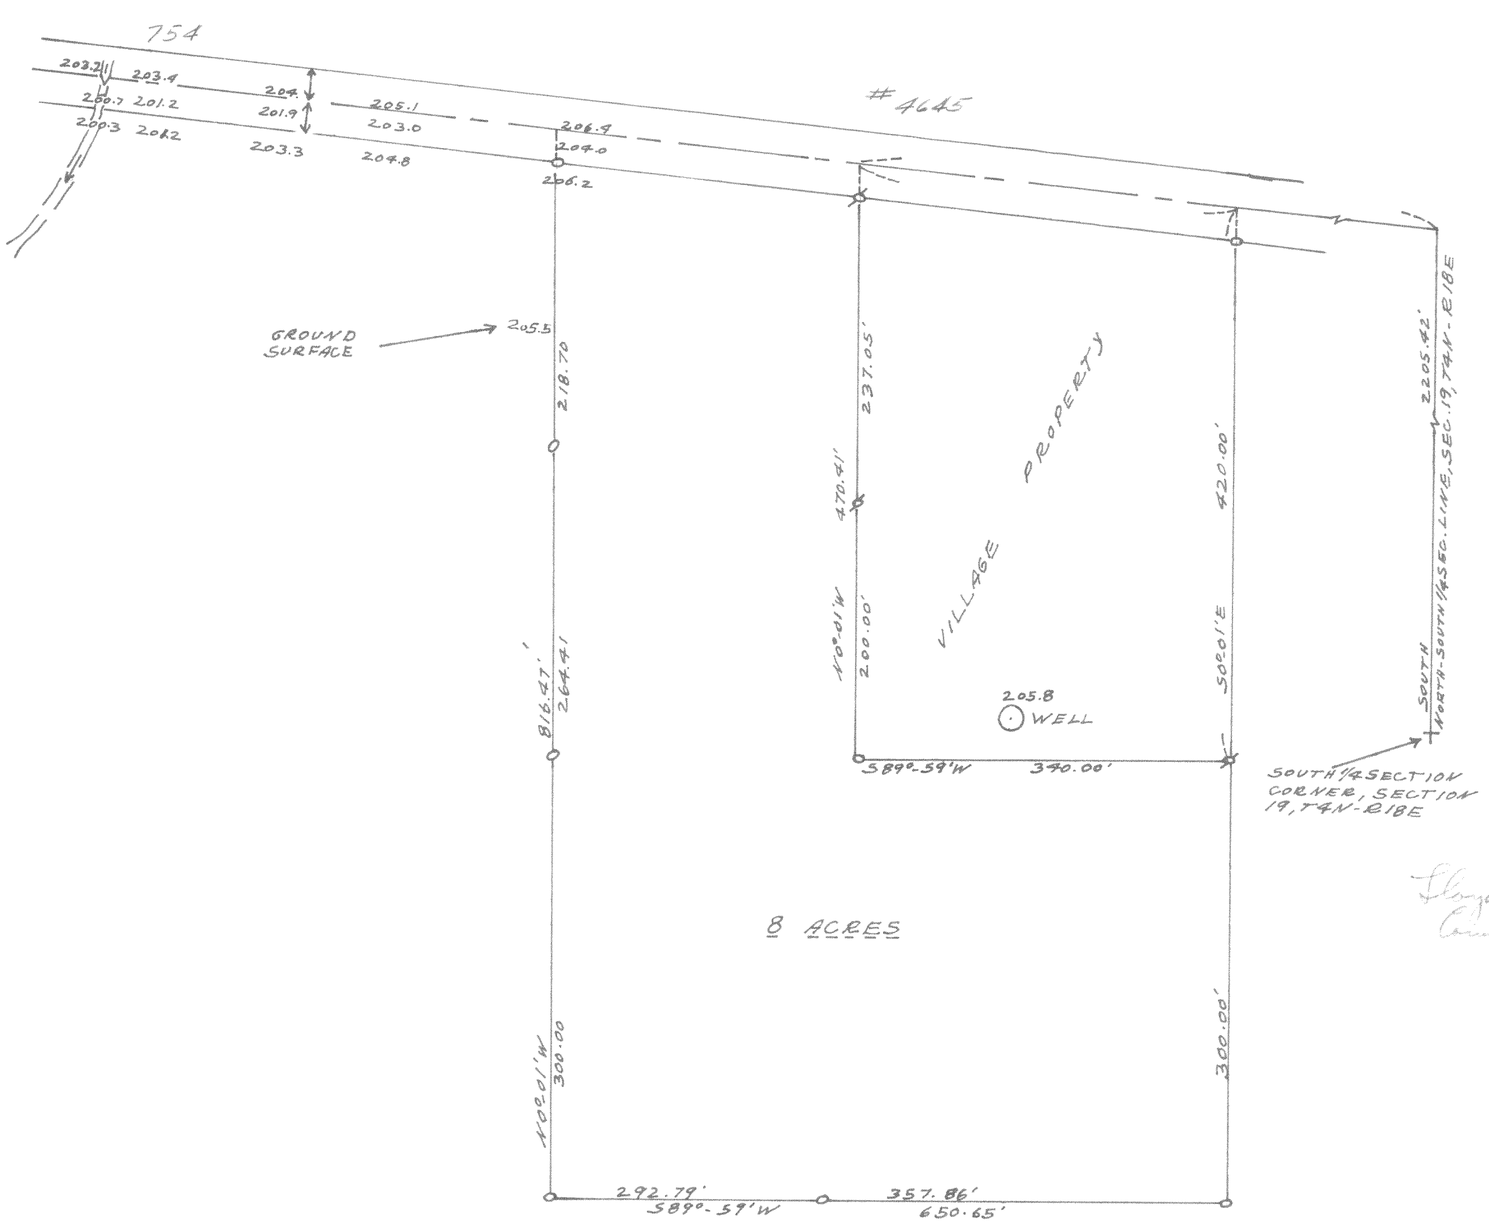


Floyd L. Jones
County Surveyor