
#2951

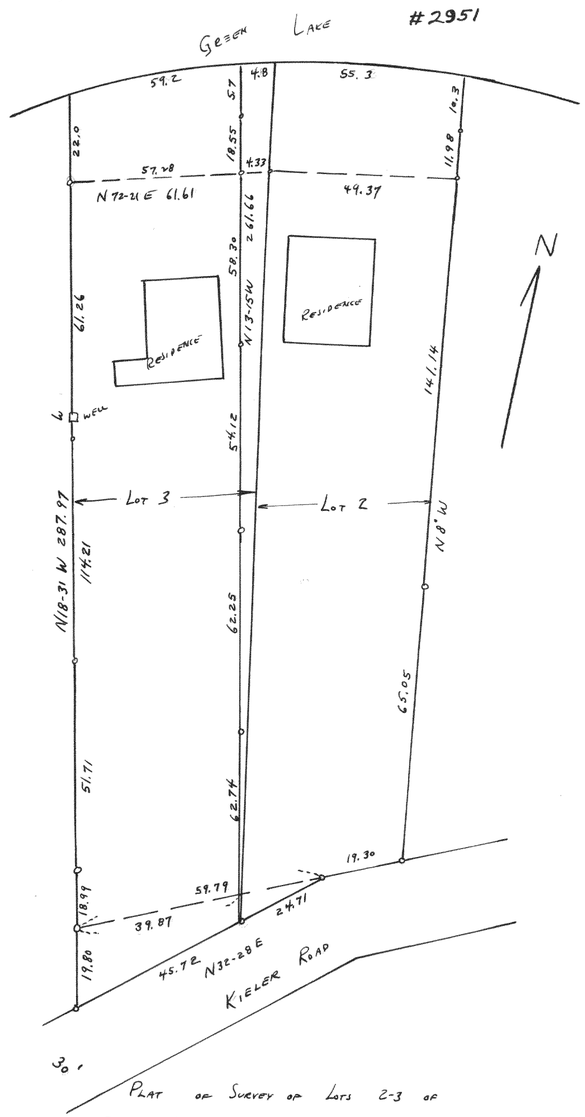

Plat of Survey of Lots 2-3 of
Sund Comfort in T4N R16E
Walworth County, Wisconsin

July 1954

Lloyd L Jones
County Surveyor

For Plat of Survey of Arrowhead Park Subd
in SW¼ Sec 35 T4N R16E see Vol ___ page ___
Plat Book in Register of Deeds office Walworth County Wisconsin


May 1954

Lloyd L Jones
County Surveyor

#2952

Plat of Survey of Parcel in S½ of 18-4-16
Walworth County Wisconsin
October 1954


Lloyd L Jones
County Surveyor

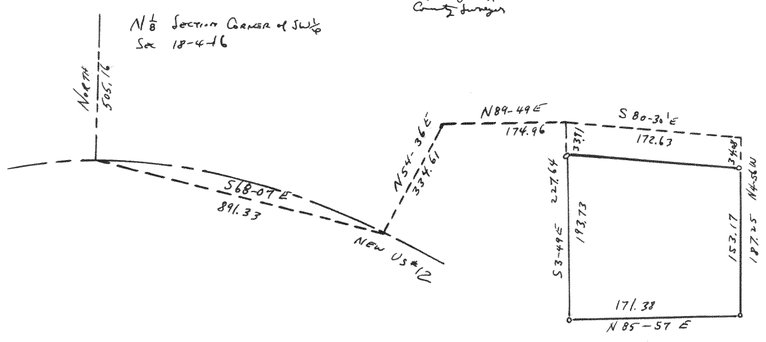

For Plat of Survey of Alta Vista Estates
in E½ Fr Section 4 T1N R17E Walworth County, Wi
see Vol ___ Page ___ of Plats Walworth County
Records
September 54

Lloyd L Jones
County Surveyor

#2953

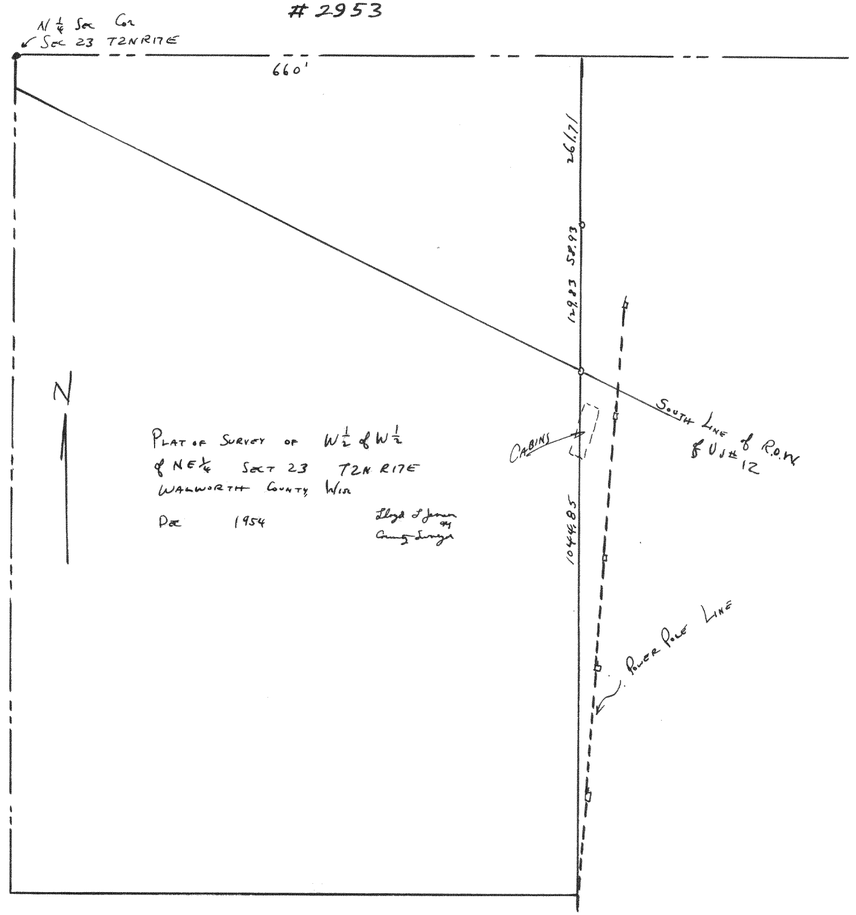

Plat of Survey of W½ of W½
of NE¼ Sect 23 T2N R17E
Walworth County Wis

Dec 1954

Lloyd L Jones
County Surveyor