
764

#4657

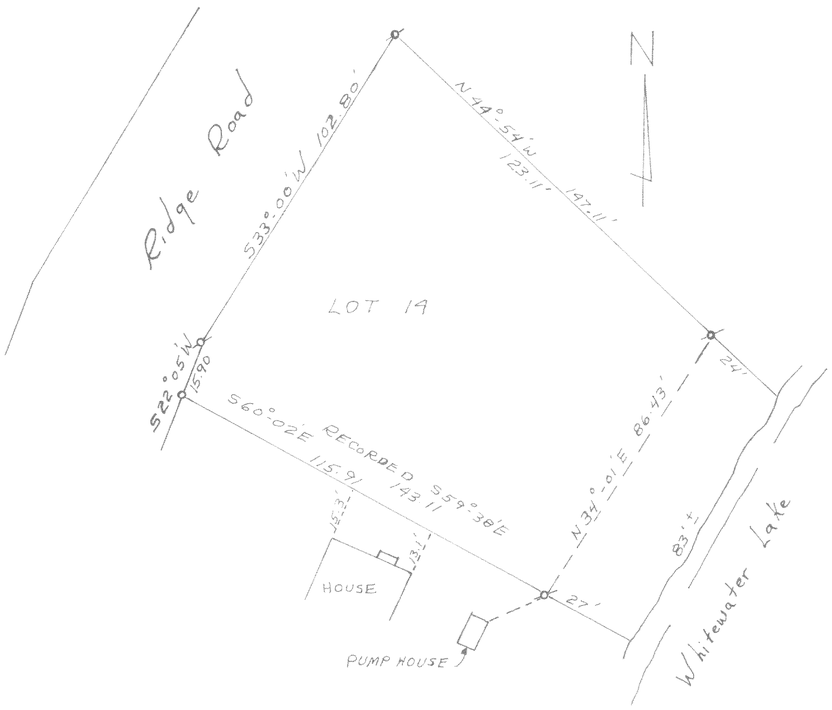


ø IRON PIPE FOUND
o IRON PIPE SET

PLAT OF SURVEY
OF
Lot 14 Block 1 Moraine Heights Subdivision
Located in Sections 26 & 35 T4N R15E
Walworth County, Wis.

MAY 1969

COUNTY SURVEYOR

#4658

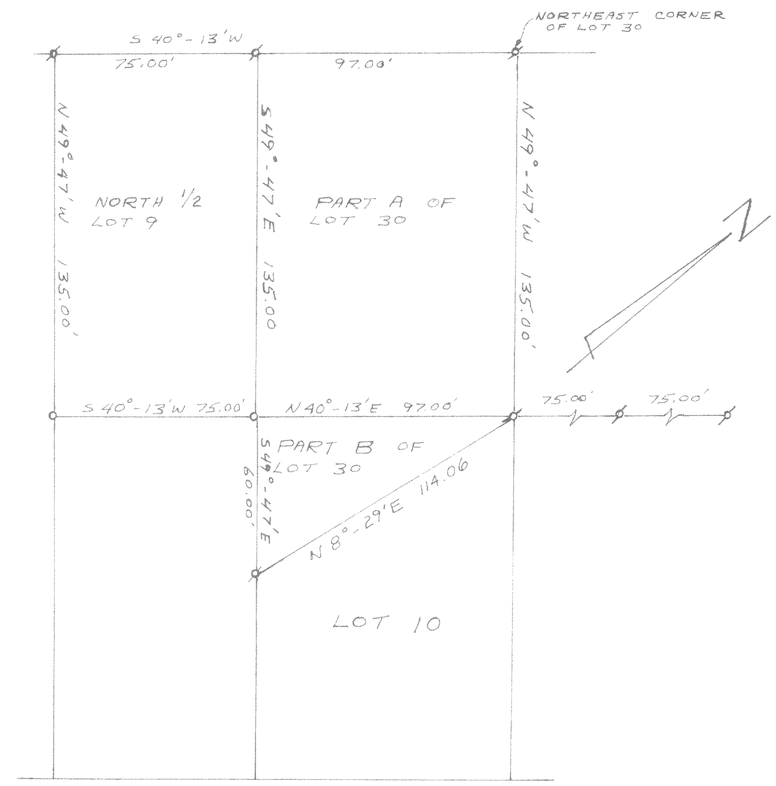

o IRON PIPE SET
ø IRON PIPE FOUND

PLAT OF SURVEY
OF
THE NORTH 1/2 OF LOT 9 & LOT 30 OF BLOCK 3
OF GRANDVIEW SUBDIVISION LOCATED IN
SECTION 34, T4N R15E WAL. CO. WISC.

OCT. 1969

COUNTY SURVEYOR