
#4662

PLAT OF SURVEY OF

LOTS 4843 - 4844 - 4846 - 4847
LAKE COMO BEACH SUBDIVISION
NE 1/4 SECTION 28, T2N - R17E
WALWORTH COUNTY, WISCONSIN.

JULY 1969

Floyd J Jensen
SURVEYOR

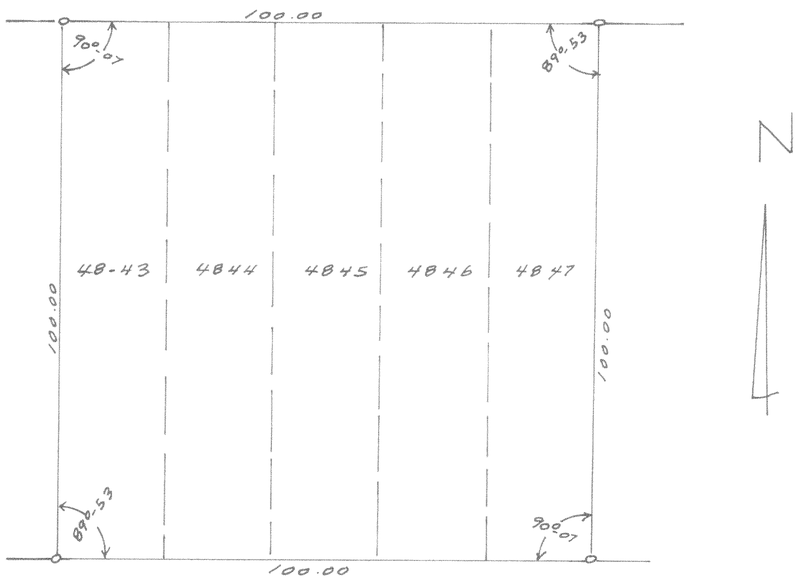


#4662

PLAT OF SURVEY OF

LOTS 3605 - 3609 AND LOTS 3637 - 3640 IN BLOCK 63 OF LAKE COMO BEACH SUBDIVISION T2N R17E, WALWORTH COUNTY, WISCONSIN

AUG 1969

Floyd J Jensen
SURVEYOR

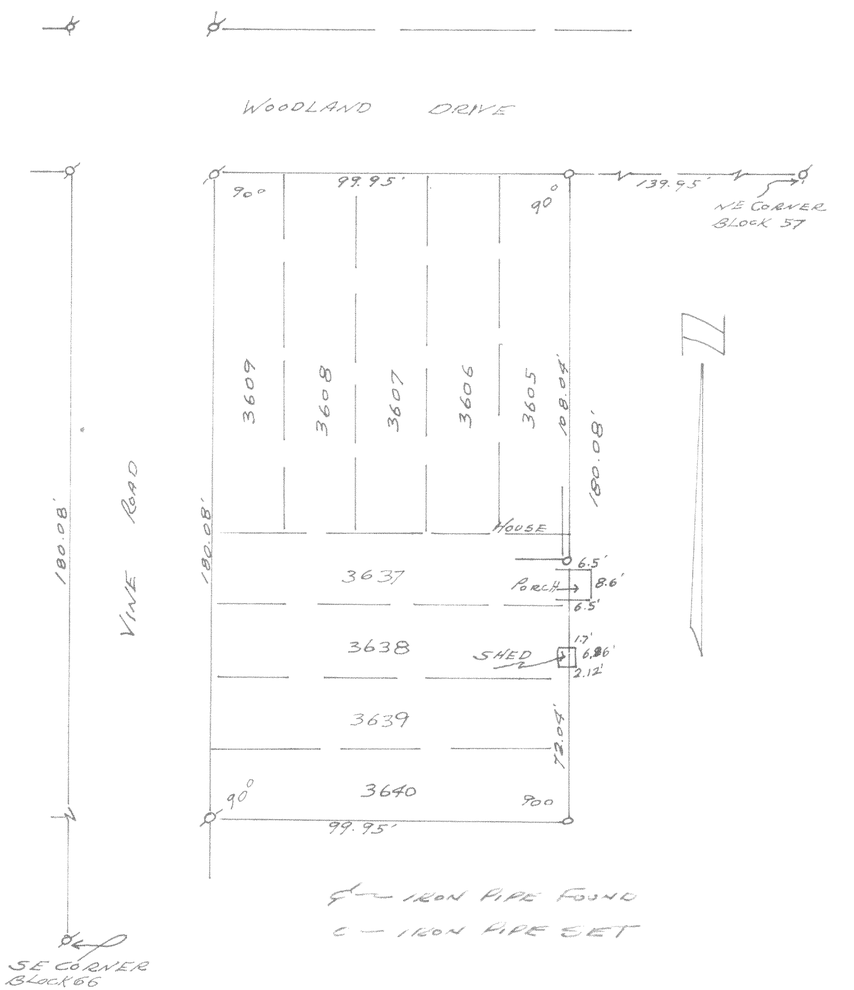

⊙ — IRON PIPE FOUND
○ — IRON PIPE SET