
#4664

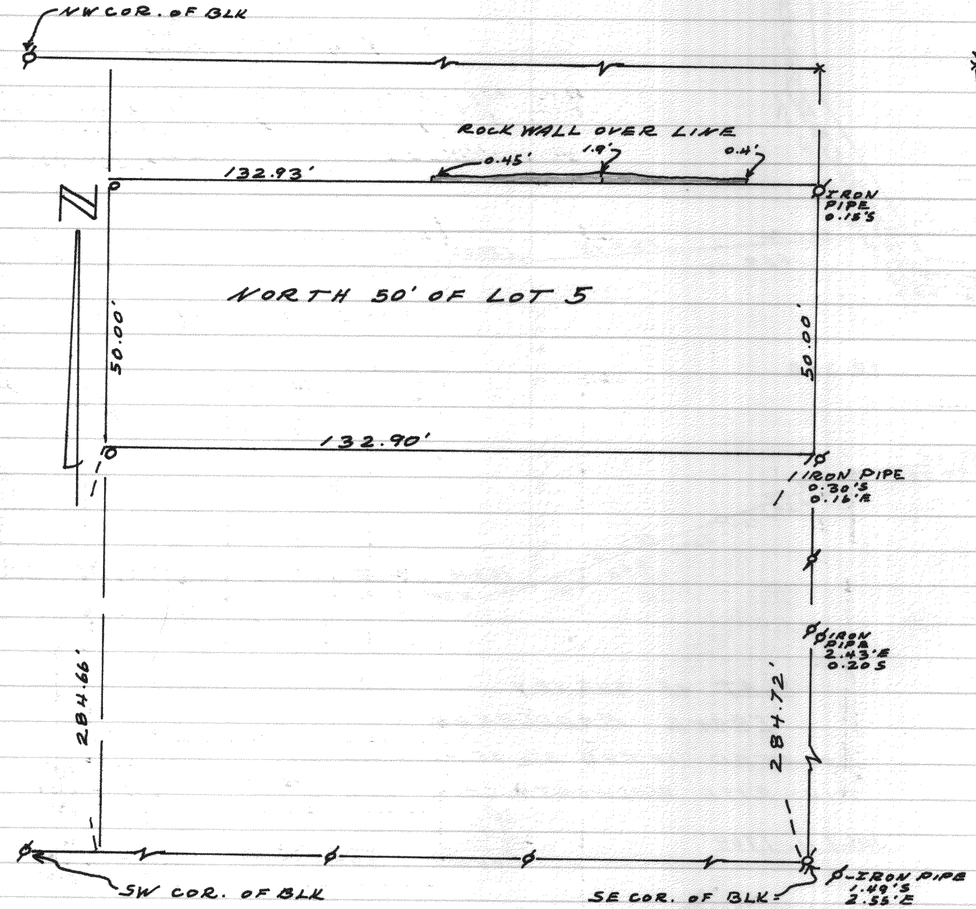


Ø — IRON PIPE FOUND
O — IRON PIPE SET

PLAT OF SURVEY
OF
THE NORTH 50.00' OF LOT 5, BLOCK 8,
ORIGINAL PLAT CITY OF ELKHORN, WISC.


JUNE 1969

Floyd L Jensen
SURVEYOR

#4665

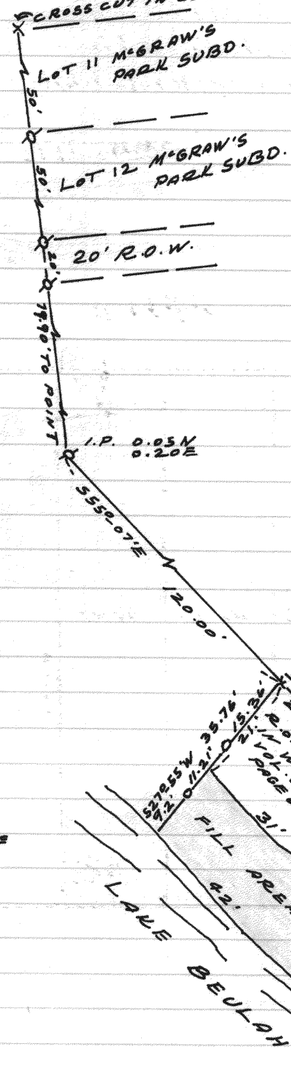

#4666

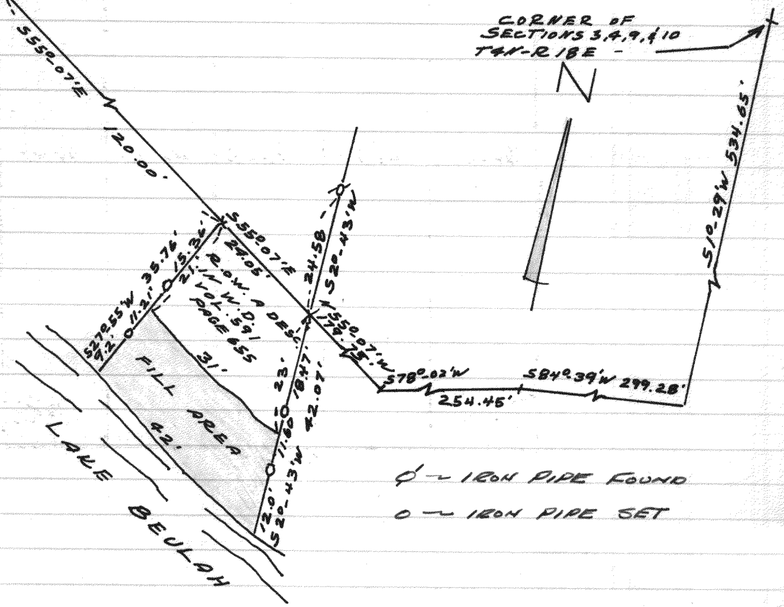

Ø — IRON PIPE FOUND
O — IRON PIPE SET

PLAT OF SURVEY
OF
ACCESS RIGHT OF WAY TO
BEULAH LAKE, LOCATED IN
THE NORTHEAST FRACTIONAL 1/4
OF SECTION 9, T4N R18E,
WALWORTH COUNTY, WISCONSIN.

JUNE 24, 1969

Floyd L Jensen
SURVEYOR