
#4667

JEFFERSON STREET

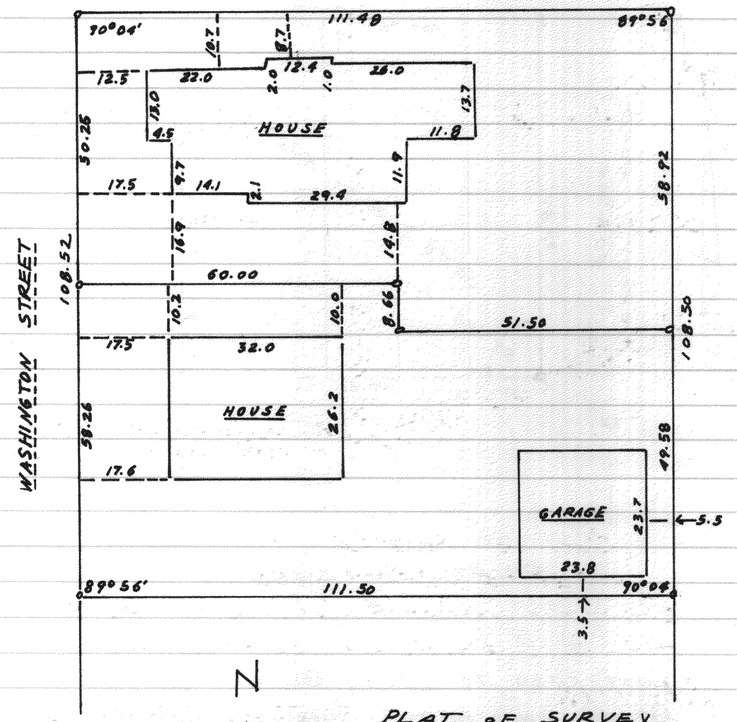

PLAT OF SURVEY
OF
THE NORTH 108.50' OF THE WEST 111.50'
BLOCK 14, OF THE ORIGINAL PLAT, CITY
OF ELKHORN, WALWORTH COUNTY, WISCONSIN.

MAY 27, 1969

Floyd L Jensen
SURVEYOR

#4668

PLAT OF SURVEY
OF
LOTS 147 → 151 AND 125 → 131
PELL LAKE ADDITION SUBD.
SW ¼ SECTION 19, T1N-R18E
WALWORTH COUNTY, WISCONSIN

JUNE 1969

Floyd L Jensen
SURVEYOR

