
772

#4669

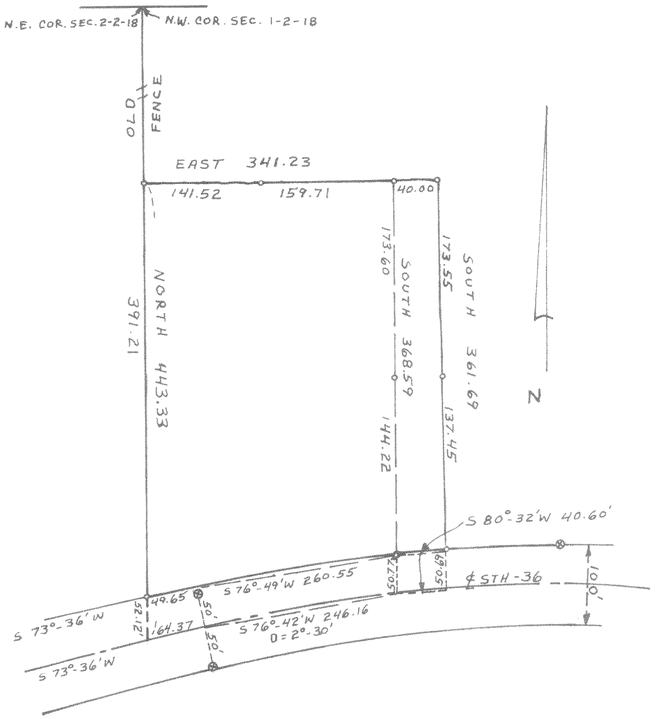

2.732 ACRES NORTH OF HIGHWAY
0.401 ACRES HIGHWAY R.O.W.
3.133 ACRES TOTAL

o IRON PIPE
⊗ R.O.W. POST

SURVEY OF PLAT


OF

PARCEL OF LAND LOCATED IN NW 1/4 OF THE NW 1/4 OF SECTION 1, T 2N, R18E WALWORTH COUNTY, WISCONSIN

AUGUST 29, 1969

COUNTY SURVEYOR

#4670

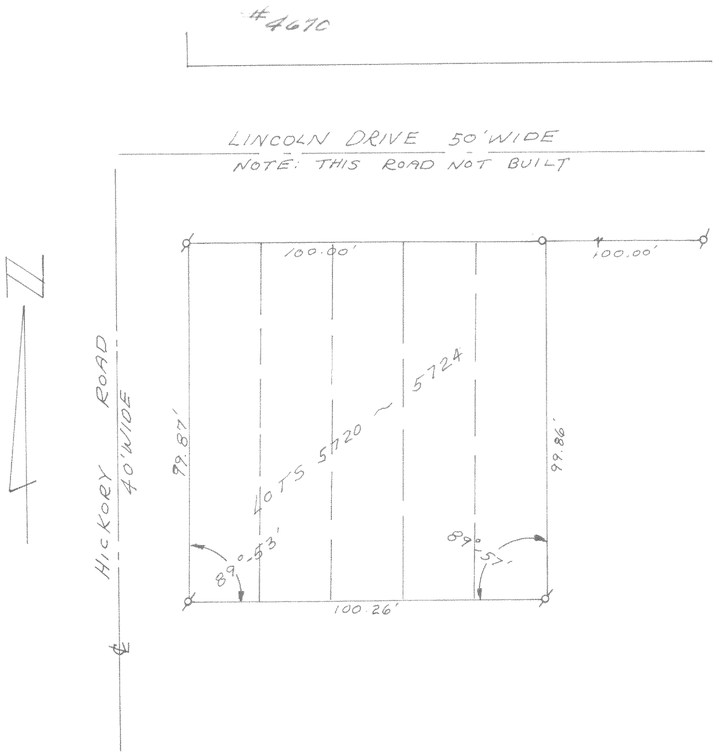

PLAT OF SURVEY

OF

LOTS 5720 TO 5724, BLOCK 102 OF LAKE COMO BEACH SUBDIVISION, WALWORTH COUNTY, WISCONSIN

o IRON PIPE SET
ø IRON PIPE FOUND

AUGUST 1968

COUNTY SURVEYOR