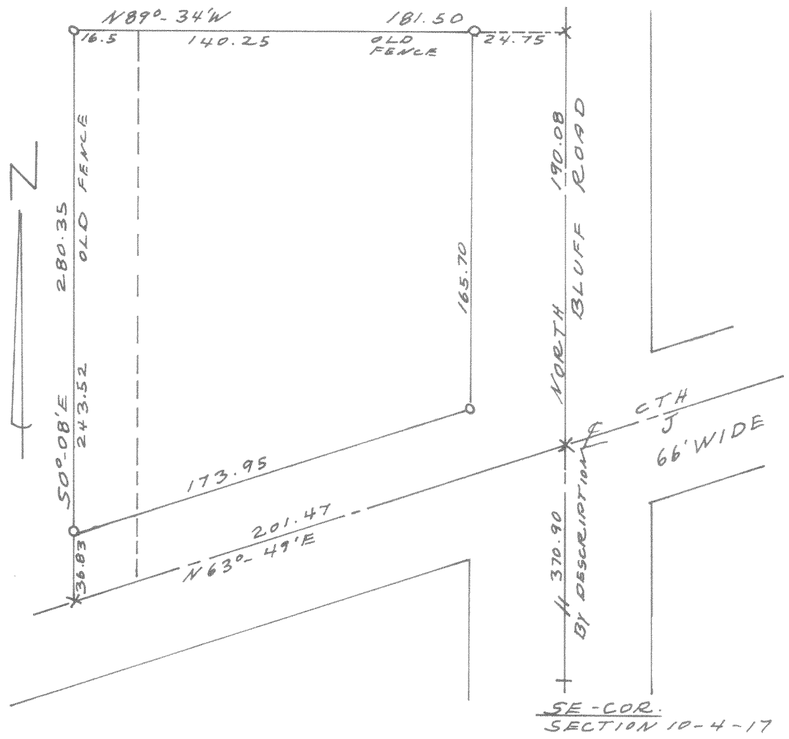
774

#4673



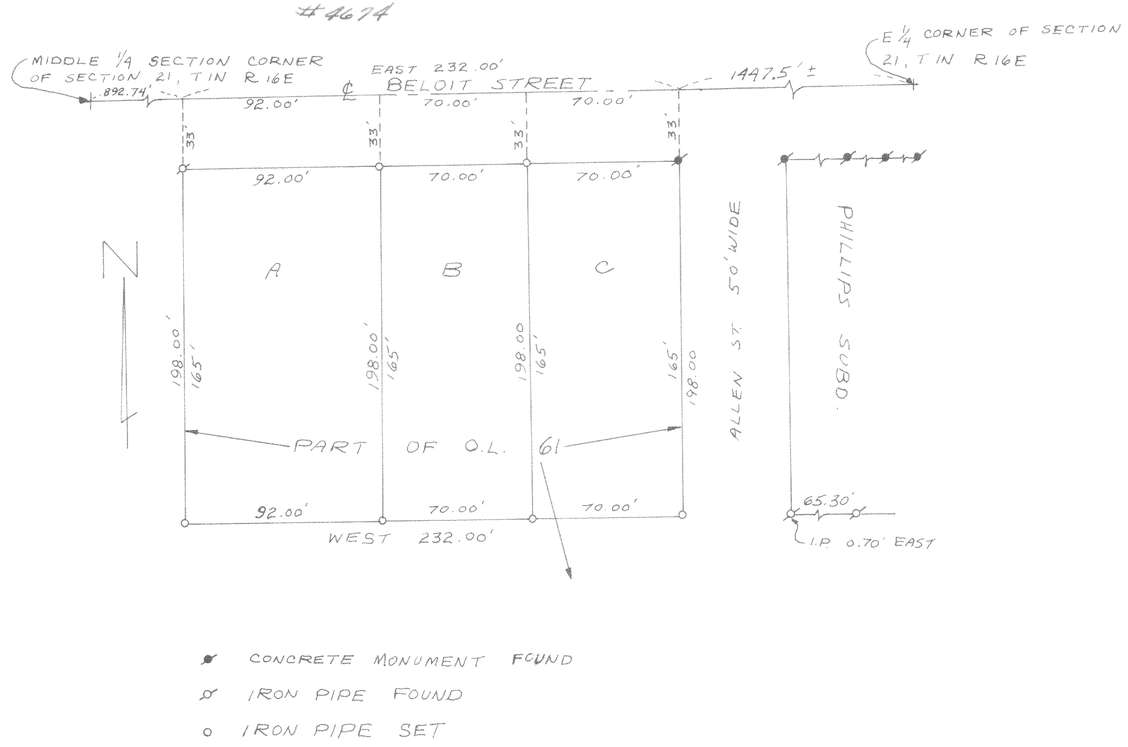

PLAT OF SURVEY
OF

PART OF THE SE 1/4 SECTION 10
T4N-R17E, WALWORTH CO., WISCONSIN.

JULY 11, 1969

Floyd L. Jensen
COUNTY SURVEYOR

#4674




● CONCRETE MONUMENT FOUND
⊗ IRON PIPE FOUND
o IRON PIPE SET

PLAT OF SURVEY
OF

A PARCEL OF LAND LOCATED IN THE SE 1/4 OF SECTION 21, T1N R16E VILLAGE OF WALWORTH, WALWORTH COUNTY, WISCONSIN, PART OF OUTLOT 61 OF THE ASSESSOR'S PLAT

DEC. 1969

Floyd L. Jensen
COUNTY SURVEYOR