
#4680

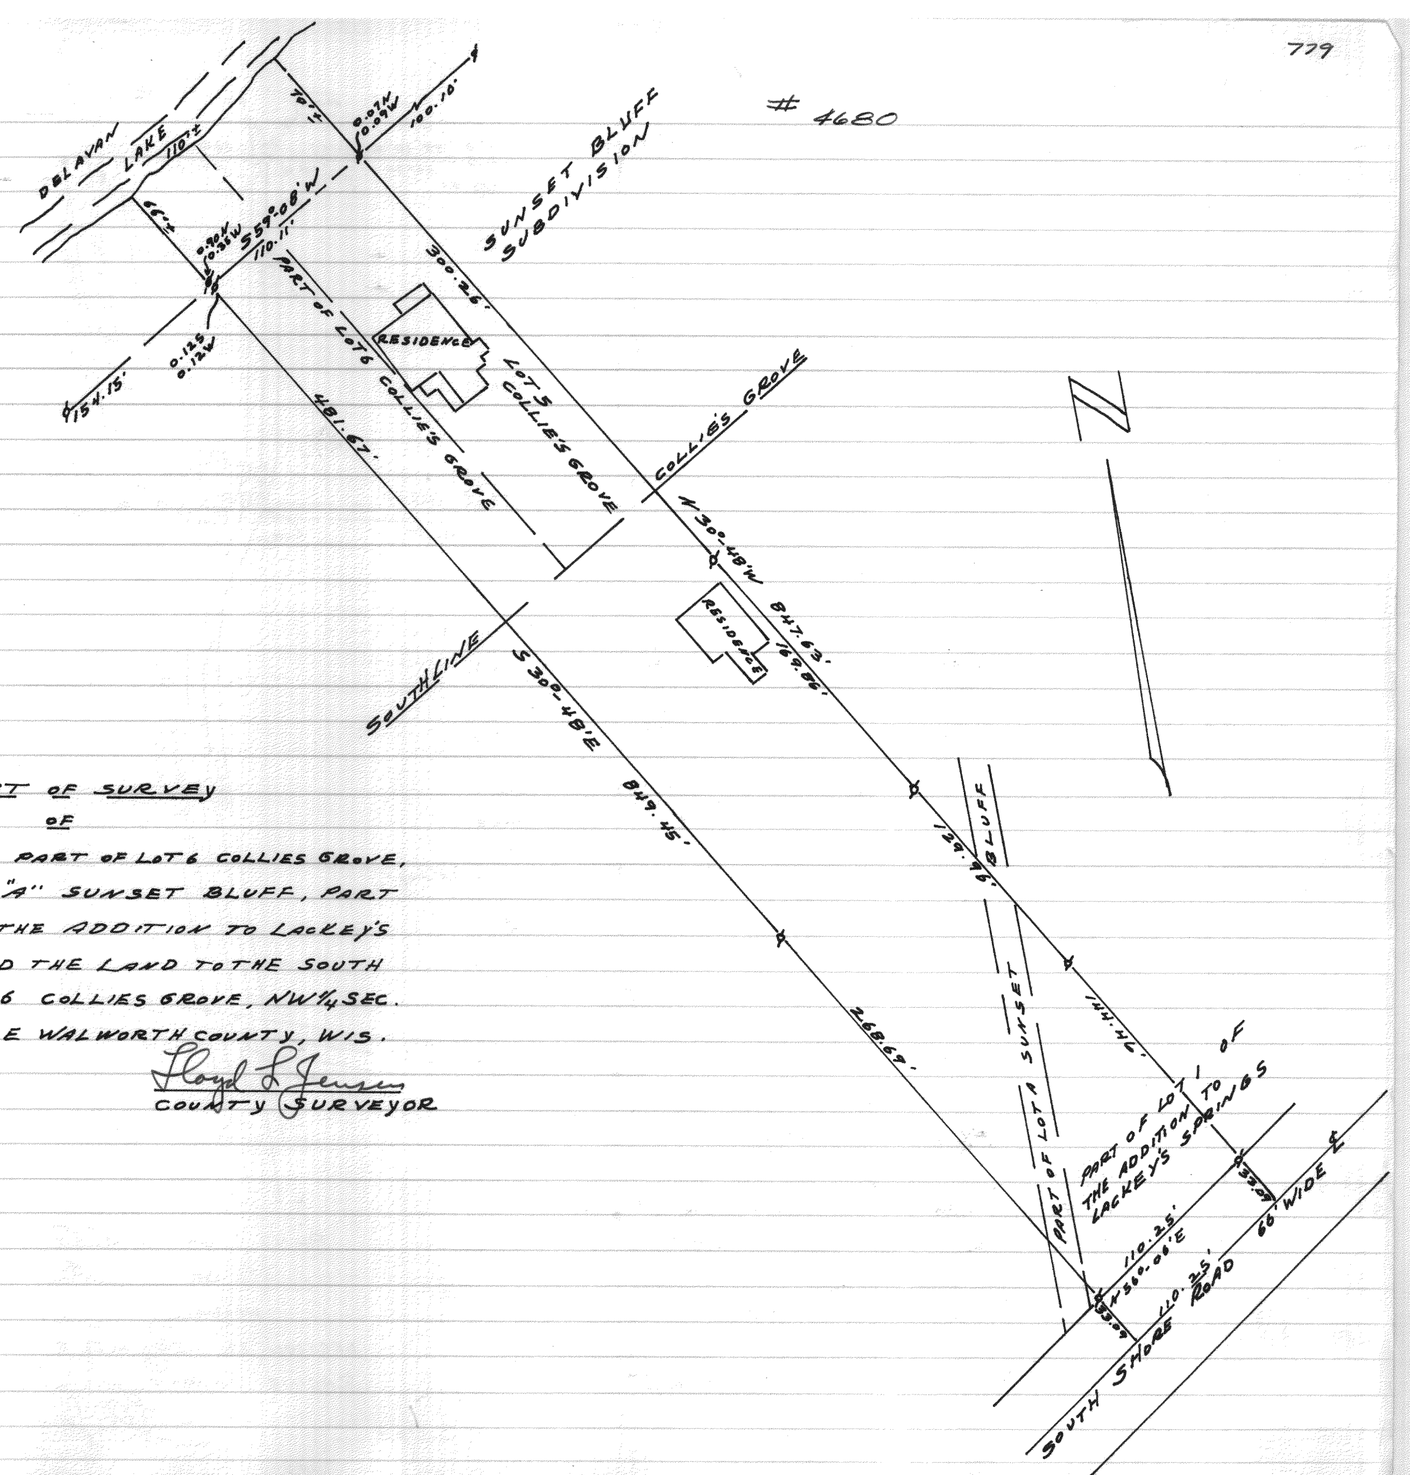

PLAT OF SURVEY
OF

LOT 5 AND PART OF LOT 6 COLLIES GROVE, PART OF LOT "A" SUNSET BLUFF, PART OF LOT 1 OF THE ADDITION TO LACKEY'S SPRINGS AND THE LAND TO THE SOUTH OF LOTS 5 & 6 COLLIES GROVE, NW¼ SEC. 33, T2N R16E WALWORTH COUNTY, WIS.

JULY 1969
SEPT. 1969

Floyd L Jensen
COUNTY SURVEYOR