
#4682


PLAT OF SURVEY OF
PART OF LOT 13 & 10 BLOCK 27
CHAPMAN'S & LUDINGTON'S ADD.
TO THE CITY OF WHITEWATER
WAL. CO. WISCONSIN.
JAN. 1965

Lloyd L Jensen
CO. SURVEYOR

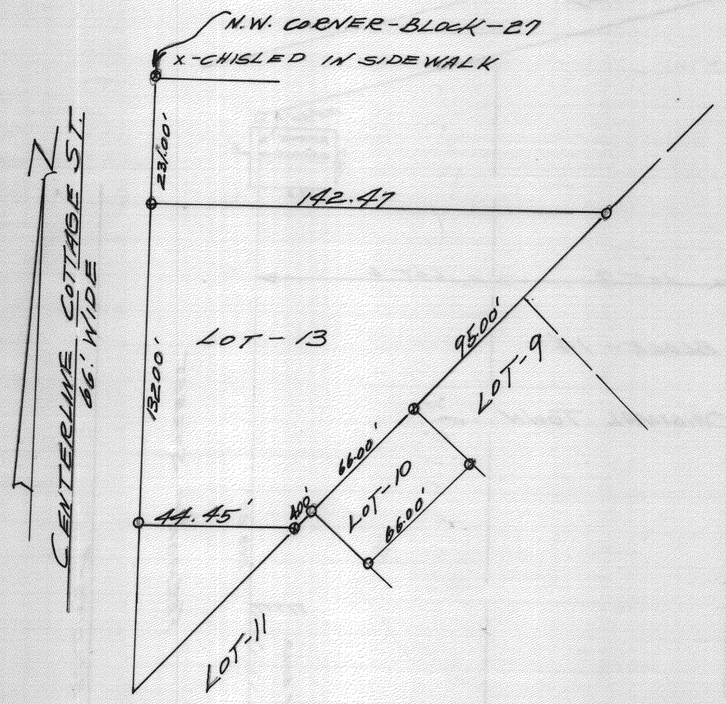

#4683

Plat of survey of 5.001 ACRES IN
SW 1/4 Section 6, T3NR18E.

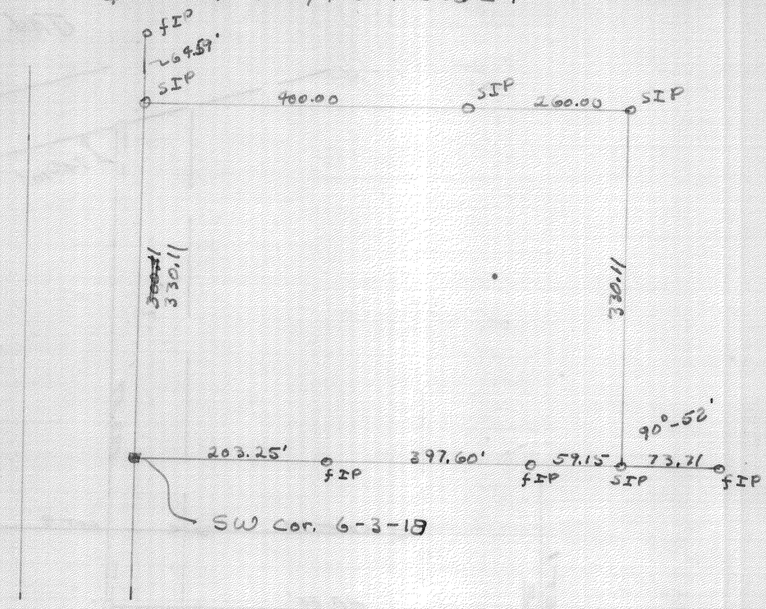

Lloyd L Jensen
County Surveyor