
#4693

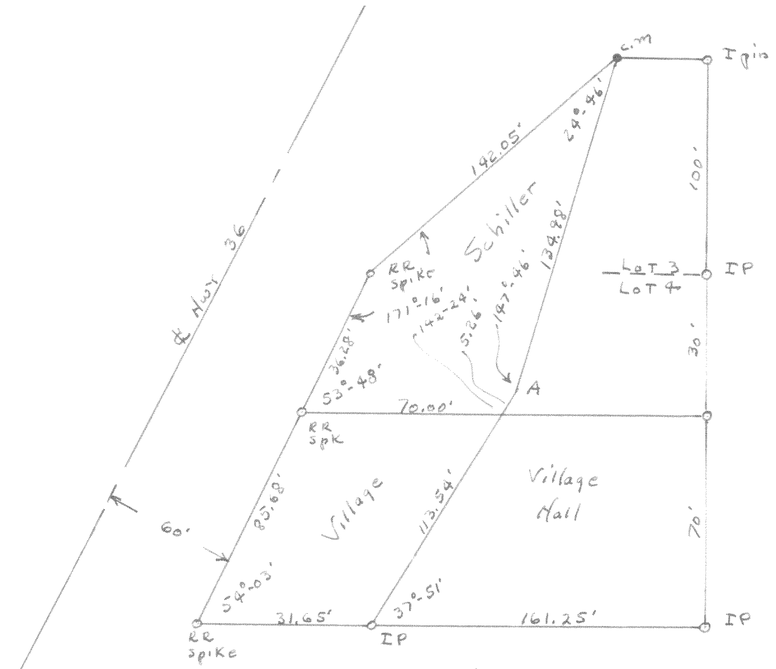


Plat of Survey of Land West of Lot 3 & 4 of Block 3 of Original Plat of Fontana.

Dec. 1965

Floyd R Jensen
County Surveyor

#4694

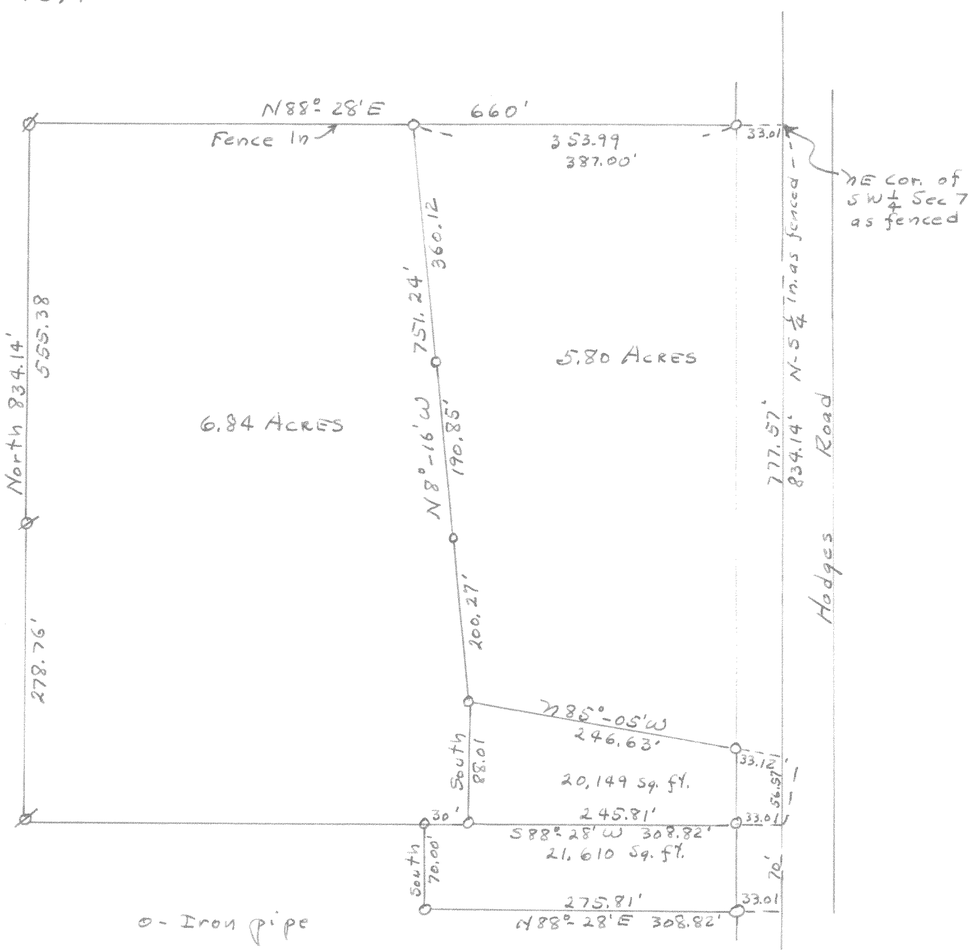

o - Iron pipe

Plat of survey of land in Southwest ¼ of Section 7, T3N R1W E.

Nov. 1968 & June 1972

Floyd R Jensen
County Surveyor