#4695

PLAT OF SURVEY

OF Floyd R Jensen SURVEYOR

MAY 1965
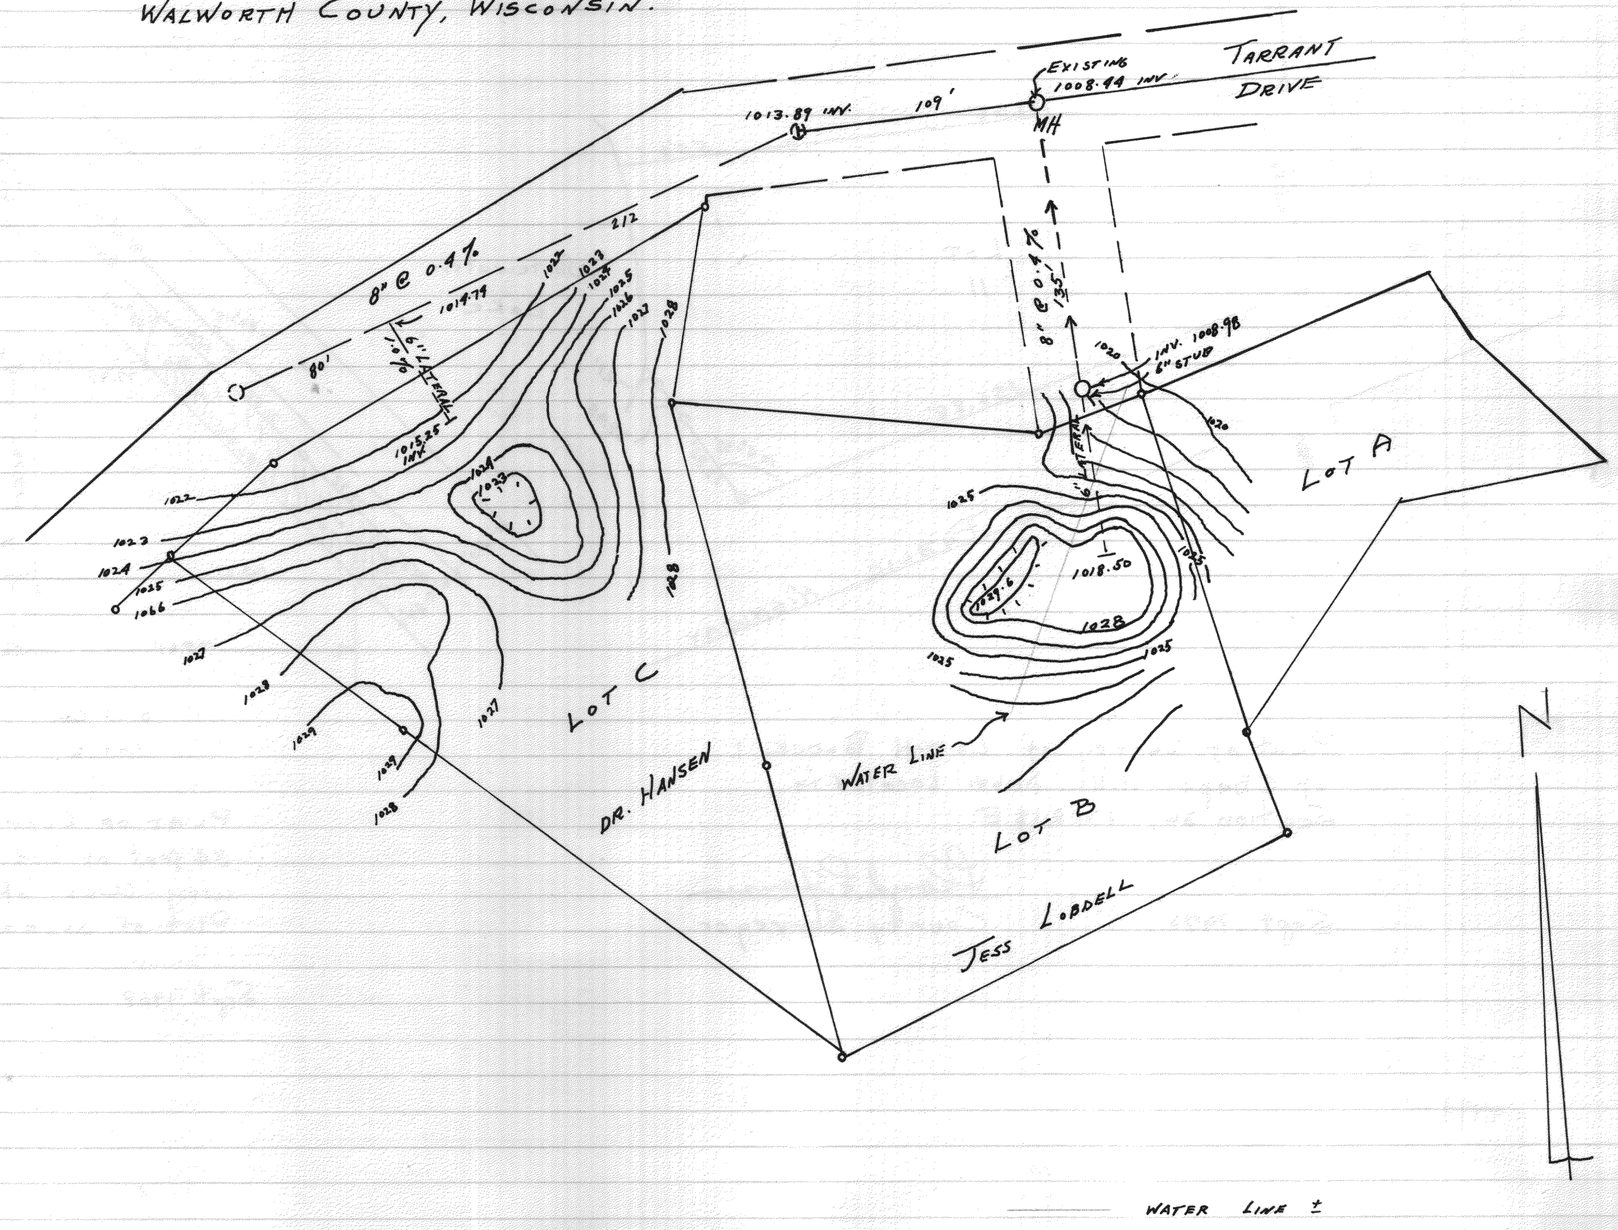
SW ¼ SECTION 14, T1N, R16E
WALWORTH COUNTY, WISCONSIN.