
#2642

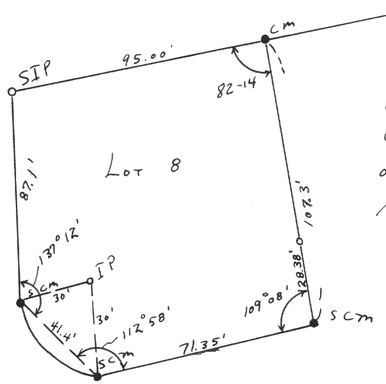


Plat of survey of Lot 8 Block F of Unit 3 of Country Club Estates of Fontana.
Aug 23 1952
Lloyd L Jensen
County Surveyor CRS.

2642A Addition A to Country Club Estates consisting of 12 Lots is recorded on Page 55 of Volume 12 of Plats for Walworth County.

May 9, 1952 Lloyd L Jensen
County Surveyor CRS

#2644

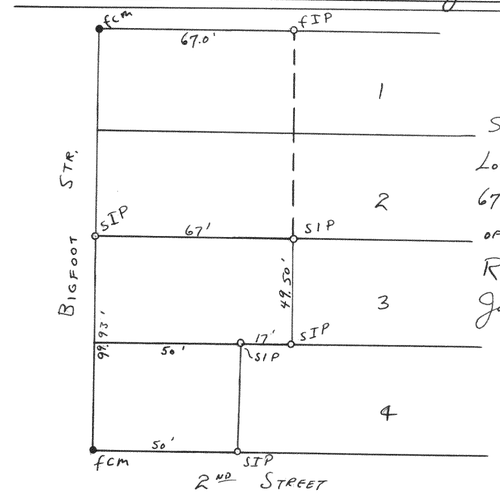

Survey of the West 50' of Lot 4 and the West 67' of Lot 3 of Block 3 of D.A. Reed's Add to Reed's Park.
June 19, 1952
Lloyd L Jensen
County Surveyor. CRS.

#2643

