

#2962

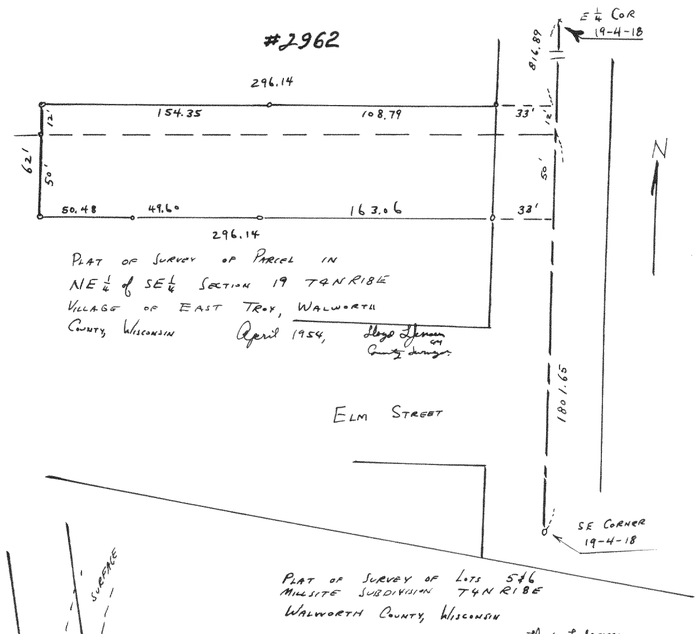


PLAT OF SURVEY OF PARCEL IN
NE ¼ of SE ¼ SECTION 19 T4N R18E
VILLAGE OF EAST TROY, WALWORTH
COUNTY, WISCONSIN April 1954, Lloyd L Jones CE County Surveyor

#2963

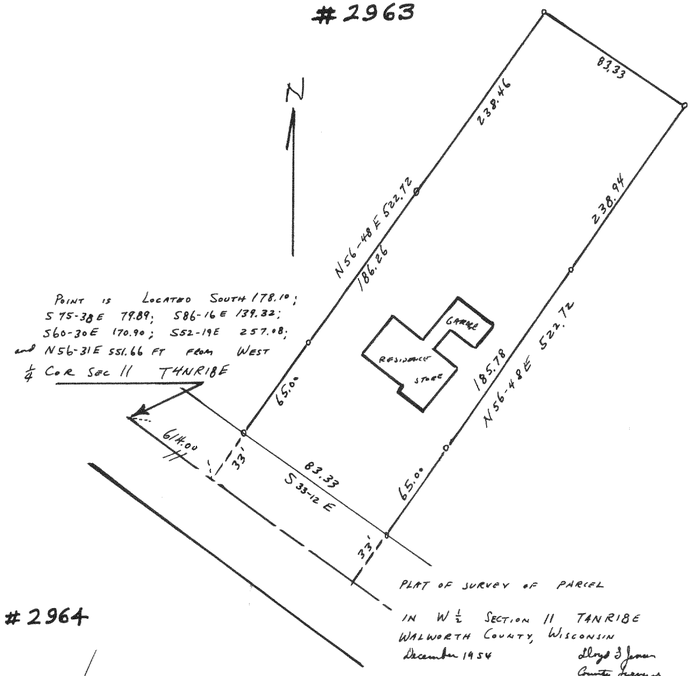


PLAT OF SURVEY OF PARCEL
IN W ½ SECTION 11 T4NR18E
WALWORTH COUNTY, WISCONSIN
December 1954 Lloyd J Jones County Surveyor

#2964

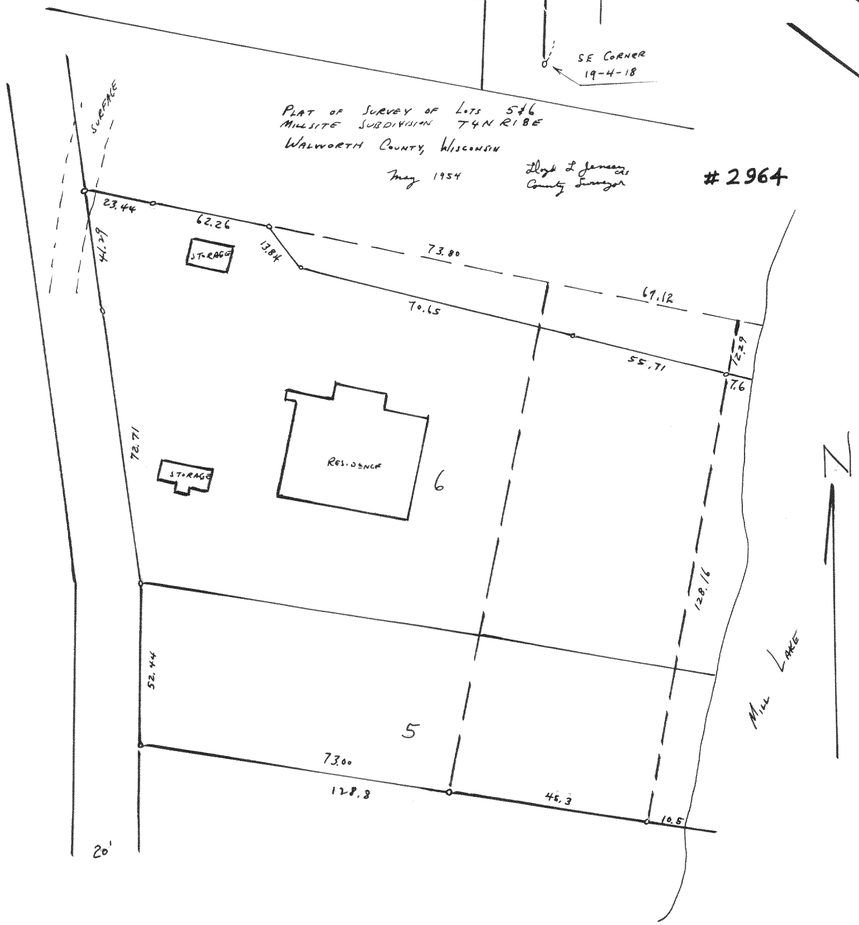

PLAT OF SURVEY OF LOTS 5 & 6
MILLSITE SUBDIVISION T4N R18E
WALWORTH COUNTY, WISCONSIN
May 1954 Lloyd L Jones CE County Surveyor

#2965

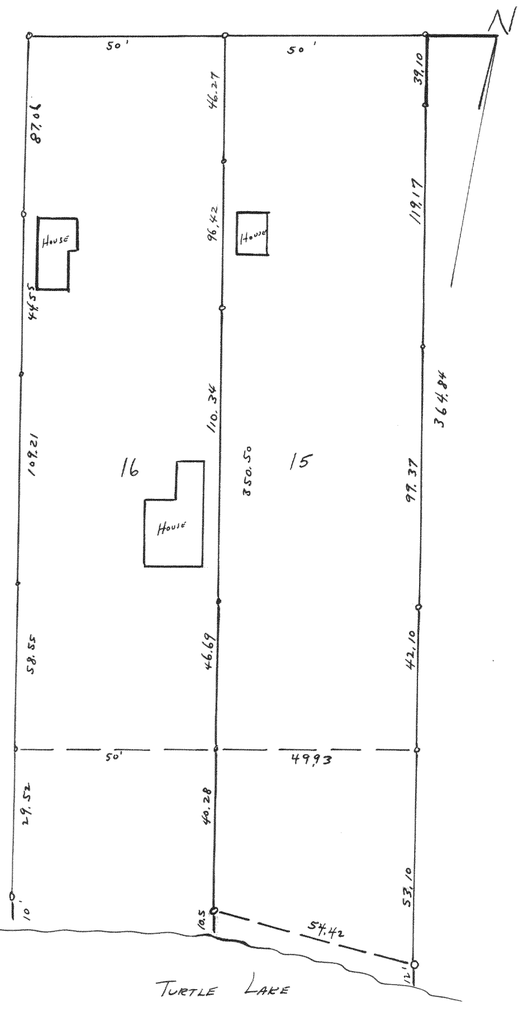

PLAT OF SURVEY OF
LOTS 15 & 16 OAK PARK
IN T3N R15E
WALWORTH COUNTY WISCONSIN
July 1954 Lloyd L Jones
County Surveyor