
#4804 PLAT OF SURVEY

SEPT. 1965

OF

PART OF OUTLOT 88, LOCATED IN THE SE1/4 - SE1/4 OF SECTION 19, T1N-R16E VILLAGE OF FONTANA, WALWORTH COUNTY, WISCONSIN.

Floyd L. Jensen
SURVEYOR

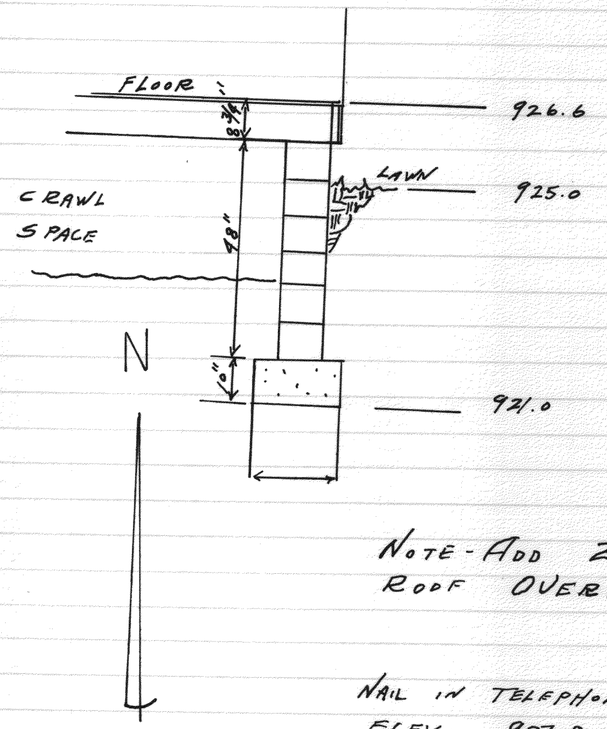

NOTE - ADD 2.00' FOR ROOF OVERHANG

NAIL IN TELEPHONE POLE
ELEV. 927.8
ELEV. 921.0 — BOTTOM FOOTING
CUT 6.8 FROM NAIL

